


Section 13 Township 10 Range 20 W

Well No. # 11 Sutor (A)

Company Sohio

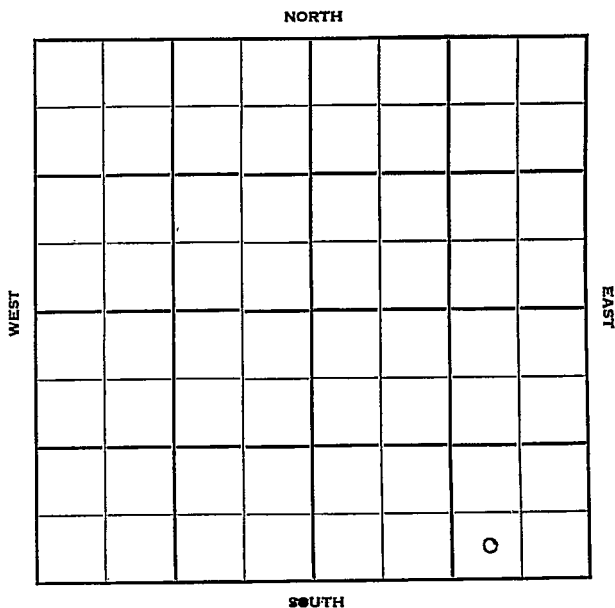

Sec. 13 Twp. 10 R. 20W

Well No. #11 Sutor (A) Farm _____

Sohio Company _____

Rine Contr- Contractor _____
Burland Pool


_____ Ft. from N. Line

330' Ft. from S. Line

990' Ft. from E. Line

_____ Ft. from W. Line

SW SE SE

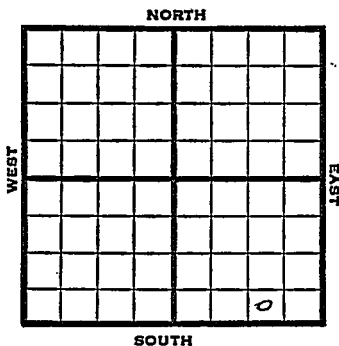

1951

Elev. 2208' REPORT

6/20
10/17

Location
Spud 9-5-51
Oil Well TD 3759
8" @ 305 Anhy 1590
Top 3203 Heeb. 3411
Dodge 3430 Lans. 3447
DST 3472-96 opn 1/2 hr Rec. 1020' gas
690' oil DST 3533-52 opn 1 hr.
Rec. 25' mud & SW & SSO
DST 3604-28 opn 1 hr Rec. 30' socm
Arb. 3749-59 5" @ 3754 TD 3759
16/3526-30 31 go & tr. wtr ph
1000 A S/114 bf 50% oil 14 hr.
SP 3510 21/3479-86 32 goph 1000A
S/14 boph Comp. 655 bopd 7% wtr.

COMPLETED

