
FORM 51 Graham KANSAS

Section 13 Township 10 Range 21W

Well No. #3 Bass "A"

Company D. G. Hansen

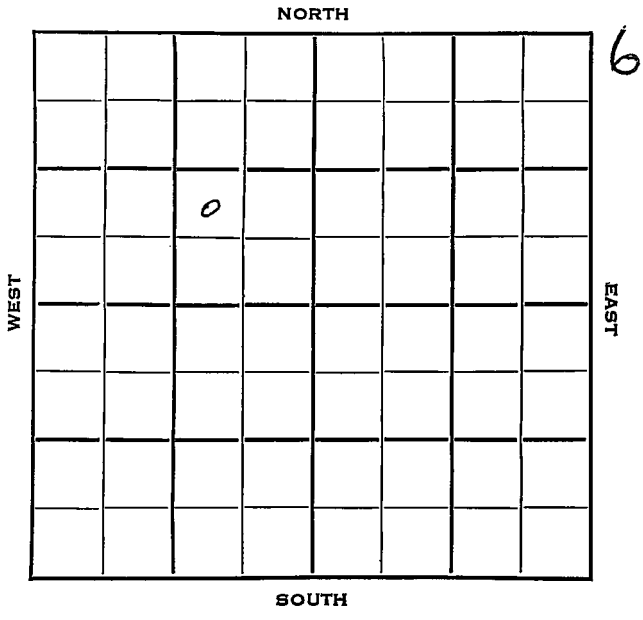

FORM 252-B

KANSAS

Graham

Sec. 13 Twp. 10 R. 21 W

Well No. # 3 Bass "A" Farm

D. G. Hansen Company

C & G Drlg. Contractor

Cooper Bool.


Ft. from N. Line

990 Ft. from S. Line

990 Ft. from E. Line

Ft. from W. Line

NW SE NW

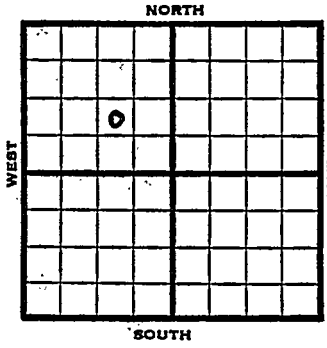

1953	Elev. 2273' REPORT
2/18	Cellar & Pits
2/26	8" @ 165 Anhy 1742' Drlg. 3490'
3/12	Tor 3516 Lans. 3536 B KC 3764 Arb. 3841 RTD 3852 5" @ 3843
3/19	NR
3/26	NR
4/2	"
4/9	"
4/16	NR
4/23	"
4/30	"
5/7	"
5/21	"
5/28	"
6/3	"
6/24	NR
7/1	Spud 2-17-53 Oil well TD 3852 8" @ 165 Anhy 1742 Top 3291 Heeb 3496 Tor. 3516 Lans 3536 B KC 3764 Arb. 3841 TD 3852 5" @ 3843 DST 3841-48 open 1 hr rec 10' mud & VSSO

OVER

1953
7/1

(Information continued)
DST 3841-52 open 1 hr rec 140' HO
& GCM 50% oil 1010#
CO to 3852
Comp. 25 BOPD 53% wtr.

COMPLETED

FORM 275 FOR SALE BY KANSAS BLUE PRINT CO.


County Graham State Kansas

Sec. 13 (Blk. Twp.) 10 (Sur. Rge.) 21W Map No.

Operator D. G. Hansen

Well No. 3 Farm Bass "A"

Elev. Location NW SE NW

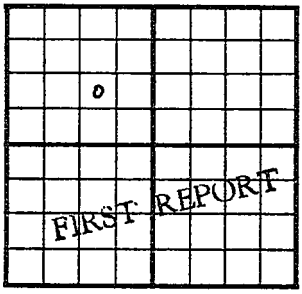

990 Ft. From S Line NW

990 Ft. From E Line Quarter

1st. Report FEB 18 1953

Completion

Remarks C & G Drlg. - Contr.

Spudding Date

Drlg. Data Cooper Pool

Cellar & pits

J. G. McGEHEE

FORM 275 FOR SALE BY KANSAS BLUE PRINT CO.


County Graham State Kansas

Sec. 13 (Blk. Twp.) 10 (Sur. Rge.) 21W Map No.

Operator D. G. Hansen

Well No. 3 Farm Bass "A"

Elev. 2273 Location NW SE NW

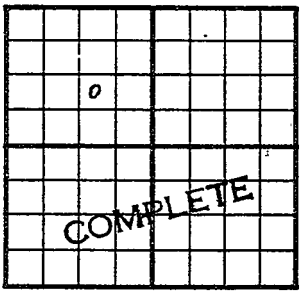

990 Ft. From S Line NW

990 Ft. From E Line Quarter

1st. Report

Completion JUL 1 1953

Remarks Cooper Pool

C & G Drlg. - Contr.

Spudding Date 2-17-53

Drlg. Data Oil well TD 3852

8" @ 165 Anhy 1742 Top. 3291

Heeb. 3496 Tor. 3516 Lans. 3536

B KC 3764 Arb. 3841 TD 3852

5" @ 3843 DST 3841-48 open 1 hr.

Rec. 10' mud & VSSO DST 3841-52 open 1 hr

Rec. 140' ho & gcm 50% oil 1010#

CO to 3852 Comp. 25 bopd 53% wtr.

J. G. McGEHEE