


Section 13 Township 10 Range 21-W

Well No. #1 Holzhauer

Company Continental
Wildcat

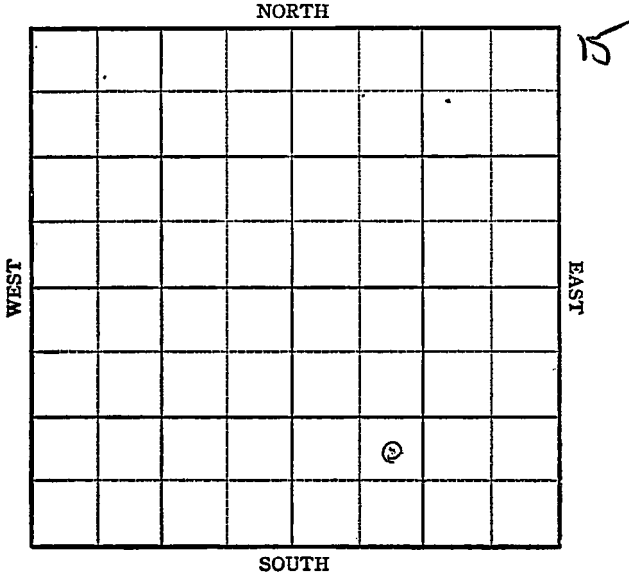

KANSAS

Sec. 13 Twp. 10 R. 21W ✓

Well No. #1 Holzauer Farm

Continental Company

Wildcat


_____ Ft. from N. Line

990' Ft. from S. Line

_____ Ft. from E. Line

990' Ft. from W. Line

NE SW SE

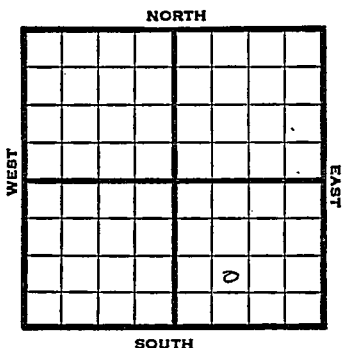

1948

Eti 2259'

R E P O R T

12/1

16" @ 222'
Drlg. 2565'

12/8

Drlg 3605'

12/15

TD 3933'
Lans 3534'
Arb. 3883'
Aband.

ABANDONED

Map No. _____ Sec. 13 Twp. 10 R. 21W

Well No. 1 Holzhauser

Continental Company

FIRST REPORT Contractor

NE SW SE

SECTION PLAT

_____ Ft. from N. Line

990 Ft. from S. Line

_____ Ft. from E. Line

990 Ft. from W. Line

Graham County

Location _____

Rig up _____

Drilling and Remarks:-

16" @ 222

drlg. 2565

RECORD

Cased _____ in., _____ ft.

Sand _____

Gas _____

Oil _____

Total Depth _____

PRODUCTION

1st 24 hrs. Nat. _____

1st 24 hrs. after shot _____

Gas _____ Cu. Ft.

Dry Hole _____

Abandoned _____

Date

DEC 1 1948 19

S. J. LEWIS Scout

