

Graham

KANSAS

Section 13 Township 10 Range 21 WWell No. # 1 HolzhauerCompany Jones, Shelburne & Farmer

							0

NORTH

WEST

EAST

SOUTH

8



Sec. 13 Twp. 10 R. 21 W

Well No. # 1 Holzhauer Farm

Jones, Shelburne & Farmer Company

Jones, Shelburne & Farmer Contractor

Wildcat

Ft. from N. Line


330 Ft. from S. Line

330 Ft. from E. Line

Ft. from W. Line

SE SE NE

Continental Farmout

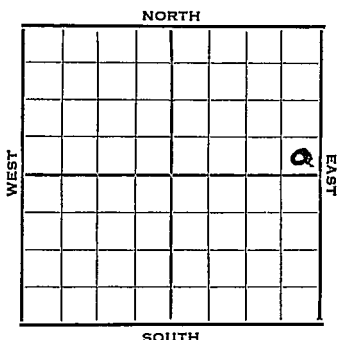

1952 Elev. 2175' REPORT

9/10 Location

9/17 "

9/24 8" @ 157 Anhy 1683'
Dr1g. 3465'


10/1 Spud 9-15-52

D & A TD 3830' 8" @ 157
Anhy 1683' Heeb 3435' Tor. 3451'
Lans. 3470' B KC 3730' Arb. 3804'
TD 3830' D & A

ABANDONED

J. G. McGEHEE

County Graham State Kansas
 Sec. 13 (Blk.) 10 (Sur.) 21W Map No.
 Operator Jones, Shelburne & Farmer
 Well No. 1 Farm Holzhauer
 Elev. 2175 Location SE SE NE

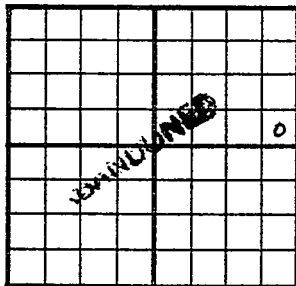

330 Ft. From S Line NE
330 Ft. From E Line Quarter

1st. Report

Completion OCT 1 1952

Remarks Wildcat

J-S*F - C6ntr.

Spudding Date 9-15-52

Drlg. Data D & A TD 3830

8" @ 157 Anhy 1683 Heeb. 3435

Tor. 3451 Lans. 3470. B KC 3730

Arb. 3804 TD 3830

D & A

J. G. McGEHEE