


Graham

Section 13 Township 10 Range 21 W

Well No. # 1 Rich Estate

Company Lehman & Johnson & G M R Oil

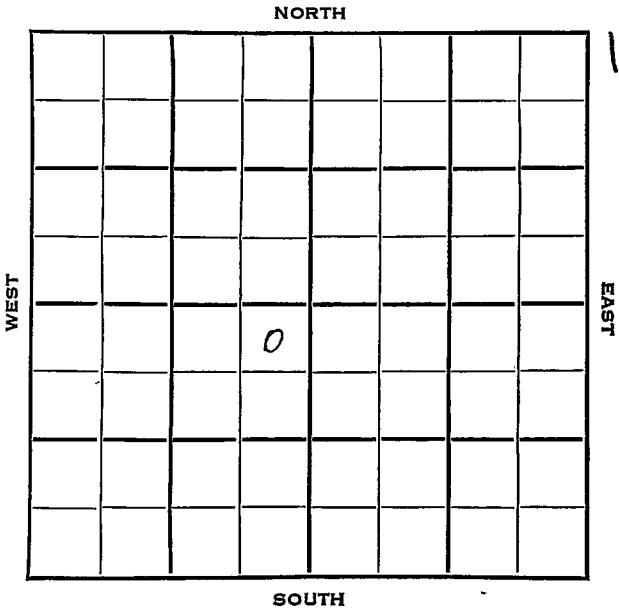

Graham KANSAS

SEC.	TWP.	R.
13	10	21W

WELL NO. 1 Rich Estate FARM

COMPANY Lohman & Johnson & G-M-R Oil

CONTRACTOR Lohman & Johnson


Bass Poll

330 Ft. from N. Line

\_\_\_\_\_ Ft. from S. Line

330 Ft. from E. Line

\_\_\_\_\_ Ft. from W. Line

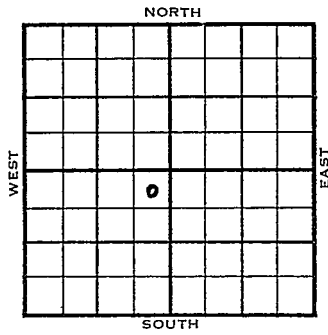

NE NE SW

	ELEVATION	REPORT
1954	2255'	

5/12 Spud 5-5-54  
8" @ 160'  
Drlg. 3435'

5/19 D & A

5/26 Spud 5-5-54  
D&A  
TD 3837'  
8" @ 160'  
Heeb 3486', Lans 3528'  
DST 3607-20', opn 1 hr., rec. 210'  
SW, 1110#  
B KC 3747', Cong. 3810', Arb. 3832'  
DST 3832-37', opn 1 hr., rec. 22'  
socm, 740#  
TD 3837'  
D&A

**ABANDONED**



