


Osborne

KANSAS

SECTION 11 TOWNSHIP 10 S RANGE 15 W

WELL NO. # 1 Isenberg

COMPANY Jones, Shelburne & Farmer

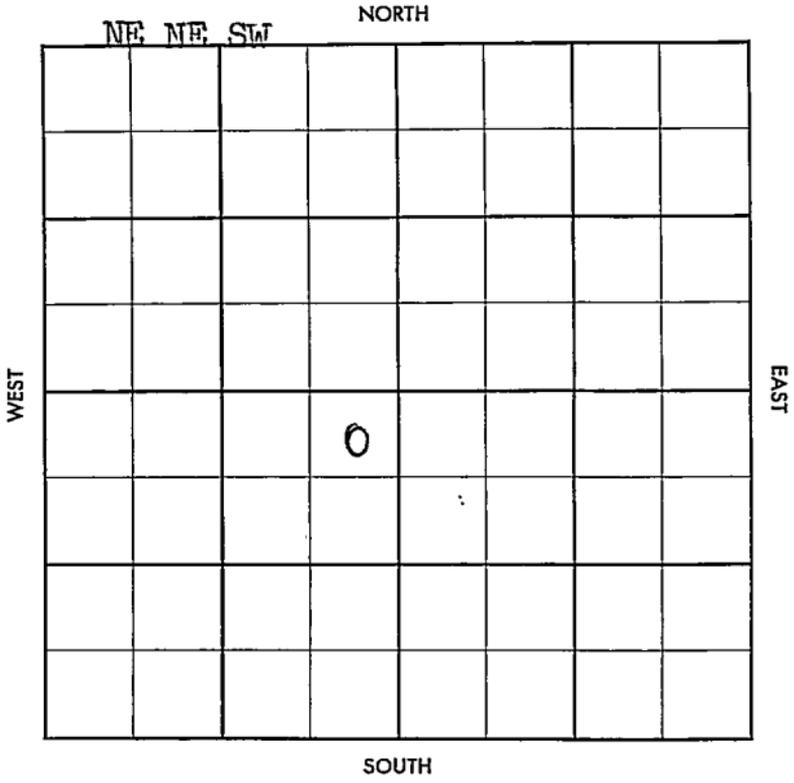

7

FORM 513 SUNRAY

County Osborne

Elev. _____

Sec. 11

Twp. 10

Rge. 15W

Company Jones Shelburne & Farmer

Farm Name Isenberg

No. 1

Co.
Sec.
No.
Sec.
T.
R.

TOPS	DEPTH	LOG	DATUM
Anh.	<u>1153</u>		
TP.			
H.	<u>3096</u>		
Tr.			
Dg.			
Bl.			
L.	<u>3176</u>		
K.C.			
B.K.C.	<u>3406</u>		
Ce.			
C.	<u>Sd C 3518</u>		
M.	<u>Chm C 3536</u>		
M.	<u>2</u>		
K.			
Mz.			
Ma.			
V.			
S.	<u>3611</u>		
S.			
A.	<u>3646</u>		
R.			
Pe.			
G.			
T.D.	<u>3655</u>		

Loc in Sec. NE NE SW

Geol. _____

Contr. _____

Pool

Ruggles

ABANDONED		
	o	
	SEP 18 '57	

Date Comm. _____

Location SEP 4 '57 9-2-57 A-578

294/150 WOC SEP SEP 1 '57

3110 SEP 18 '57 no log

D & A