


Rooks

KANSAS

SECTION 14 TOWNSHIP 10S RANGE 16W

WELL NO. #1 Rogers

COMPANY C.S.O.

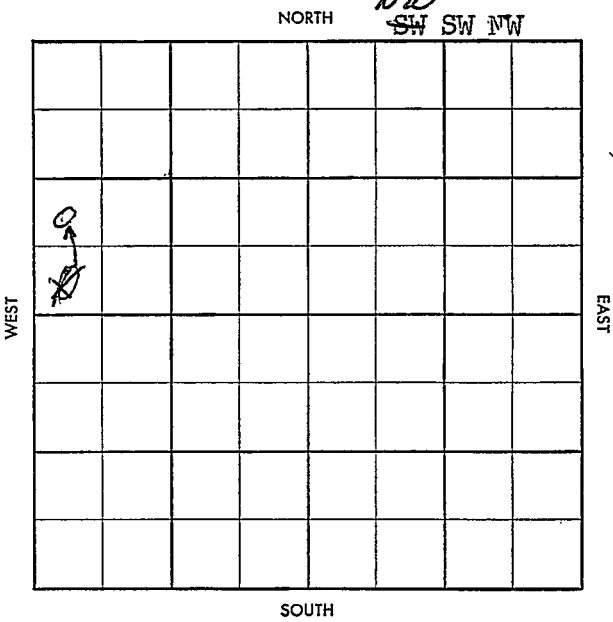

WILDCAT

S-513-B

County Rooks Elev. _____
 Sec. 14 Twp. 10 Rge. 16W
 Company C. S. O.
 Farm Name Rogers No. 1

TOPS	DEPTH	LOG	DATUM
Anh.			
Tp.			
H.			
Tr.			
Dg.			
B.L.			
L.			
K.C.			
B.K.C.			
Ce.			
C.			
M.			
M.			
K.			
Mz.			
Mq.			
V.			
S.			
S.			
A.			
R.			
Pf.			
G.			
T.D.			

Loc. in Sec. SW SW NW

Geol. _____
 Contr. _____

Pool Wildcat

FIRST REPORT
 MAR 5 58

Date Comm. _____
Location SDX 3/4 mile

Co.
 Twp.
 R.

Twp X Pool X

Co. X Facet X

O.W.W.O.

S-513-B

County Rooks Elev. 19120 F 19151 A

14 Twp 10 Rge. 16W

G. S. O.

Name Rogers No. 1

TOPS	DEPTH	LOG	DATUM
Anh.	<u>1105</u>		
Tp.	<u>2804</u>		
H.	<u>3039</u>		
Tr.	<u>3063</u>		
Dg.			
B.L.			
L.	<u>3085</u>		
K.C.			
B.K.C.	<u>3361</u>		
Ca.			
C.	<u>Cherty 3424</u>		
M.			
M.			
K.			
Mz.			
Mq.			
V.			
S.			
S.			
A.	<u>3490</u>		
R.			
Pf.			
G.			
T.D.	<u>3520</u>		

Loc NW Sec. SW SW NW
~~SW SW NW~~

Geol. _____
 Contr. _____
 Pool Wildcat

ABANDONED
 MAY 14 '58
 3/8 mile

Date Comm. 4-28-58

Location MAR 17 '58 MAR 19 '58 MAR 19 '58 MAR 19 '58 APR 2 '58

APR 9 '58 APR 16 '58 APR 23 '58 APR 30 '58 8" 320/225

02653 MAY 7 '58 DST 2826-50 1hr

37' 50cm BHP 850/30 DST 3045-76

1hr 14'M BHP 85/45" DST 3093-3106

1hr 9'M BHP 33/45" DST 3109-30 1hr

42'M+W BHP 1120/45 DST 3243-71 1hr

12'M BHP 350/45 Ø 3323 MAY 14 '58 DST 3416

-37 1hr 20' m BHP 215/15

Log D-6A