

Section 14 Township 10 Range 18 WWell No. # 2 SheppardCompany Murfin Drlg.

NORTH

							0

WEST

EAST

SOUTH

16

Rooks

KANSAS ✓

Sec. 14 Twp. 10 R. 18WWell No. #2 Sheppard FarmMurfin Drlg. Company


Contractor

Ft. from N. Line

330 Ft. from S. Line330 Ft. from E. Line

Ft. from W. Line

SE SE SE

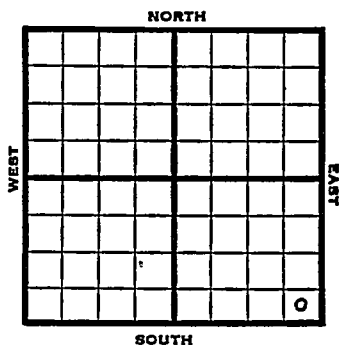

1952 Elev. 2117' REPORT

12/3 MIR


12/11 Ø/1651

12/18 Heeb 3309 Lans 3393 DST 3394-3440
 1/2 Hr. 90' Muddy wtr 1130 #15" DST
 3505-21 3/4 Hr. 25' M & SO Ø3560

12/23 Spud 12-5-52
 D & A TD 3750' Heeb 3309'
 Lans. 3393'
 DST 3394-3440 open 1/2 hr. rec 90' mud
 & wtr. 1130#
 DST 3505-21, open 3/4 hr, rec 25' mud
 & SO Cong. 3618'
 DST 3618-24, open 35 min, rec 5' OCM
 O#. Arb. 3704' TD 3750'
 D & A

ABANDONED

J. G. McGEHEE

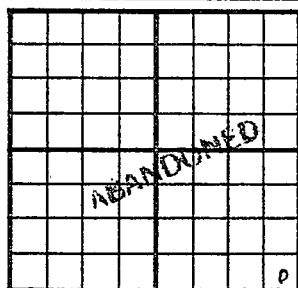County _____ Rocks _____ State KansasSec. 14 (Blk. Twp.) 10 (Sur. Rge.) 18^W Map No. _____Operator Murfin Drlg.Well No. 2 Farm SheppardElev. 2117 Location SE SE SE330 Ft. From S Line SE330 Ft. From E Line Quarter1st. ReportCompletion DEC 23 1952RemarksSpudding Date 12-5-52Drlg. Data D & A TD 3750Heeb. 3309 Lans. 3393 DST 3394-3440open $\frac{1}{2}$ hr. Rec. 90' mud & wtr. 1130#DST 3505-21 open $\frac{3}{4}$ hr. Rec. 25' mud &SO Cong. 3618 DST 3618-24 open 35 min.Rec. 5' ocm 0# Arb. 3704 TD 3750D & A

J. G. McGEHEE