
KANSAS Rooks

FORM 51 10M 12-46 PETROL

Section 14 Township 10 Range 18W

Well No. 1 Finnesy

Company Continental et al

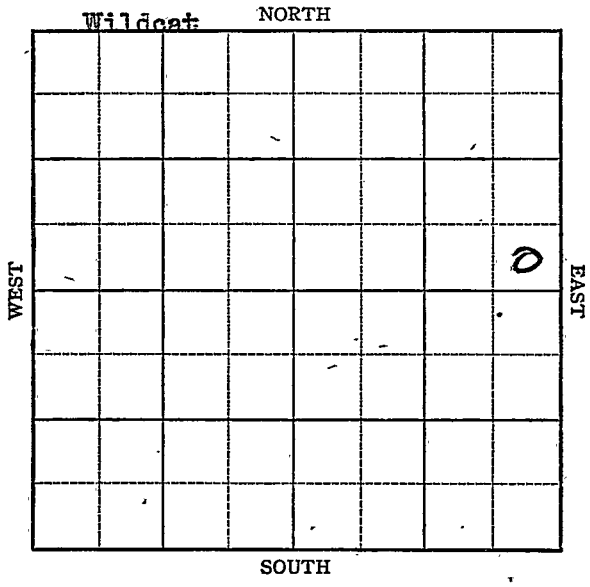

FORM 252-A
5M 12-46 PETROL

KANSAS Rooks

Sec. 14 Twp. 10 R. 18W

Well No. #1 Finnesy Farm

Continental et al Company

Wildcat


____ Ft. from N. Line

330 Ft. from S. Line

330 Ft. from E. Line

____ Ft. from W. Line

SE NE

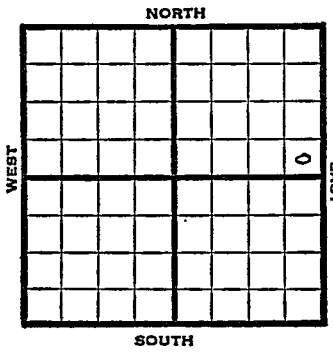

1947	REPORT
8/6	Location
8/13	Drlg. 190'
8/20	18" @ 205' Drlg. 2685'
8/27	Lansing 3370' Drlg. 3526'
9/3	Arbuckle 3753-59 TD 405" c 3755 rust
9/10	"
9/17	TD 3763' PB 3701' 58 shots. 3542-58' Swab 24 bbls. oil in 24 hrs. 1000 acid.
9/24	Plug 3454' 48 shots 3419-37' 1000 acid Swabb 55 bbls. oil + 79 W in 48 hrs.
10/1	Drill plugs to 3694' Swab 26 bbls. oil + 65 W in 24 hrs.

OVER

1947

10/8 Lans. 3382'
Arg. 3753
7" @ 3755'
Perf. Lans.
2000 Acid
Pump 26 oil / 65 W Pot
TD 3763'
Gravity 28

COMPLETED

Form 26 200 Bks. 10-46 Petrol

Kansas Wildcat

Map No. ____ Sec. 14 Twp. 10 R. 18W


Well No. 1 Finnesy

Continental etal.
Company

FIRST REPORT
Contractor

SE NE

SECTION PLAT

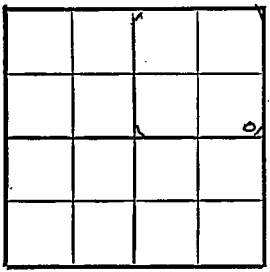

____ Ft. from N. Line

330 Ft. from S. Line

330 Ft. from E. Line

____ Ft. from W. Line

Rooks County

Location X

Rig up

Drilling and Remarks:

RECORD

Cased ____ in., ____ ft.

Sand

Gas

Oil

Total Depth

PRODUCTION

1st 24 hrs. Nat.

1st 24 hrs. after shot

Gas ____ Cu. Ft.

Dry Hole

Abandoned

Date

AUG 6 1947 19

S. J. LEWIS
Scout

Form 26 200 Bks. 10-46 Petrol

Wildcat

Kansas

Map No. 64 Sec. 14 Twp. 10 R. 18W

Well No. 1 Finnesy


Continental etal. Company

COMPLETE Contractor

SE NE

E1, 2152

SECTION PLAT

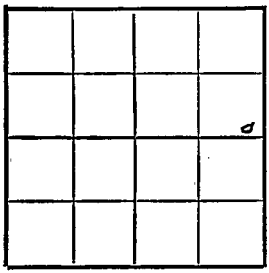

____ Ft. from N. Line

330 Ft. from S. Line

330 Ft. from E. Line

____ Ft. from W. Line

Rooks, County

Location

Rig up

Drilling and Remarks:

Lans 3382'
Cer 3753
7" @ 3755
Perf Lans.
1000 acid
Pump 26 oil +
WSW Pot 250 BO

RECORD

Cased ____ in., ____ ft.

Sand

Gas

Oil

Total Depth 3763

PRODUCTION

1st 24 hrs. Nat.

1st 24 hrs. after shot

Gas ____ Cu. Ft.

Dry Hole

Abandoned

Date

OCT. 8 1947

19 S. J. LEWIS Scout