


KANSAS

Rooks

Section 14 Township 10 Range 19-W

Well No. #1 Catudal

Company Cities Service Oil

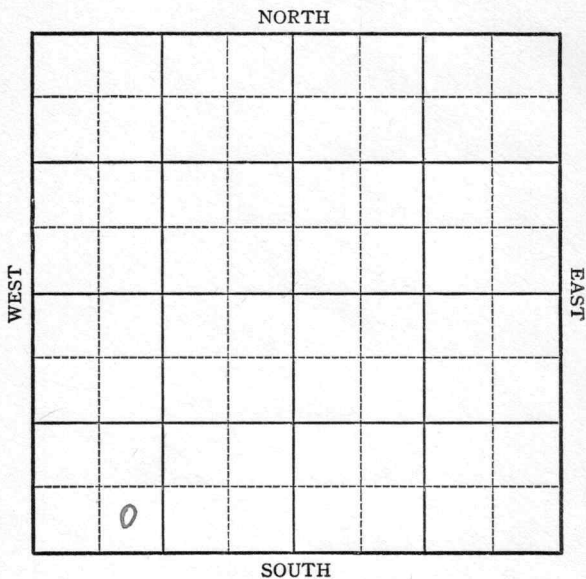

Map No. K-65 Sec. 14 Twp. 10 R. 19W

Well No. 1 Catudal

Cities Service Oil Company

FIRST REPORT Contractor

SE SW SW


_____ Ft. from N. Line

390 Ft. from S. Line

_____ Ft. from E. Line

990 Ft. from W. Line

SECTION PLAT

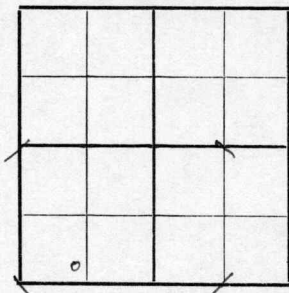

WILDCAT

Location XX

Rig up _____

Drilling and Remarks:

RECORD

Cased _____ in., _____ ft.

Sand _____

Gas _____

Oil _____

Total Depth _____

PRODUCTION

1st 24 hrs. Nat. _____

1st 24 hrs. after shot _____

Gas _____ Cu. Ft.

Dry Hole _____

Abandoned _____

Date

NOV 12 1941 19

S. J. LEWIS Scout

