

KANSAS

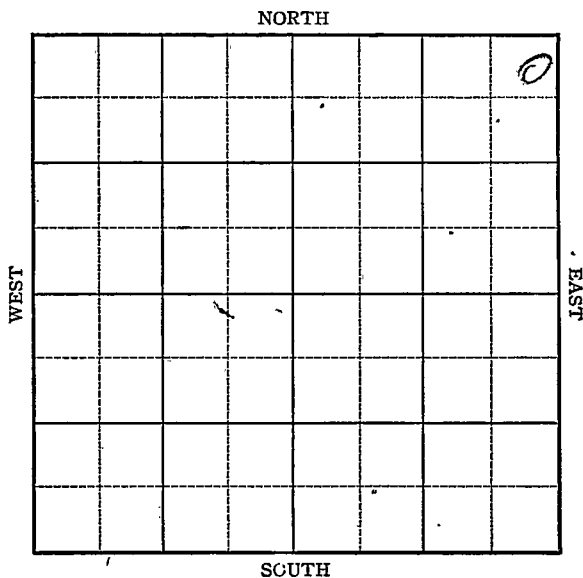
Rooks County

FORM 51 5M 11-44 PETROL

Section 14 Township 10 Range 19W

Well No. 1 H. J. Vosh

Company Darby & Bothwell

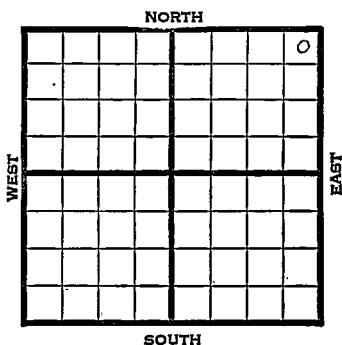


KANSAS

Rooks

Sec. 14 Twp. 10 R. 19WWell No. 1 H. J. Vosh FarmDarby & Bothwell Company

Wildcat

330 Ft. from N. Line Ft. from S. Line400 Ft. from E. Line Ft. from W. Line

NE/e

REPORT

1945

Elev. 2092

5/29

Location

6/8

13" @ 115 Drlg. 220

6/14

Anhy 1442

6/21

Drlg. 2575!

Topeka 3058

Lams 3298

SO TD3469

Run csg

6/28

8" @ 1214

Cong 3515

Arb 3549

TD 3502

Sat Run 5"

7/3

5" @ 3549

TD 3562 $\frac{1}{2}$

2800 oil. Run liner.

7/11

TD 3562 $\frac{1}{2}$ 2000 acid.

Pump 193 oil 14 hrs.

7/18

Arb. 3557

5" @ 3549

19' of 4" liner

TD 3562 $\frac{1}{2}$

Pump 380 Pot.

Grav. 29.0

COMPLETED

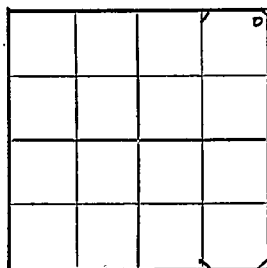
Kansas Pool Name WildcatMap No. 65 Sec. 13 Twp. 10 R. 19WWell No. 1 H. J. VoshDarby & Bothwell Company

FIRST REPORT

Contractor

NE/ c

SECTION PLAT

330 Ft. from N. Line

_____ Ft. from S. Line

400 Ft. from E. Line

_____ Ft. from W. Line

Rooks CountyLocation X

Rig up _____

Drilling and Remarks:

RECORD

Cased _____ in., _____ ft.

Sand _____

Gas _____

Oil _____

Total Depth _____

PRODUCTION

1st 24 hrs. Nat. _____

1st 24 hrs. after shot _____

Gas _____ Cu. Ft.

Dry Hole _____

Abandoned _____

Date

MAY 29 1945 19 S. J. LEWIS Scout

Kansas Pool Name WildcatMap No. 2 Sec. 14 Twp. 10 R. 19WWell No. 1 H. J. VohsDarby and Bothwell

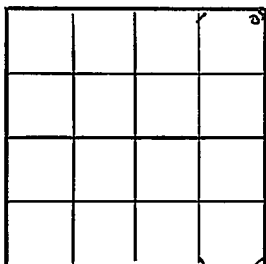
Company

CORRECTION

Contractor

NE/c

SECTION PLAT

330 Ft. from N. Line Ft. from S. Line330~ Ft. from E. Line Ft. from W. LineRooks CountyLocation Rig up

Drilling and Remarks:

Reported in 13-10-19W

RECORD

Cased in., ft.Sand Gas Oil Total Depth

PRODUCTION

1st 24 hrs. Nat. 1st 24 hrs. after shot Gas Cu. Ft.Dry Hole Abandoned

Date

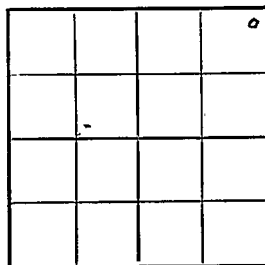
JUN 13 194519S. J. LEWIS

Scout

KANSAS Kansas Pool Name WildcatMap No. 65 Sec. 14 Twp. 10 R. 19WWell No. 1 H. J. VohsDarby & Bothwell Company**COMPLETED**

Contractor

NE/c

E 12092
SECTION PLAT330 Ft. from N. Line Ft. from S. Line400 Ft. from E. Line Ft. from W. Line

Rooks County

RECORDLocation Rig up

Drilling and Remarks:

Cased in., ft.Sand Gas Oil Total Depth 3562 1/2**PRODUCTION**1st 24 hrs. Nat. 1st 24 hrs. after shot Gas Cu. Ft.Dry Hole Abandoned

Date

JUL 1 8 1945 19

S. J. LEWIS Scout

290 ft

Cr 83557
 5' 03549
 19' 2 1/4" liner
 Pump 380 ft