

Section 14 Township 10 Range 19W

Well No. 1 Vohs "v"

Company Darby-Bothwell

Zurick

NORTH

						0	

WEST

EAST

SOUTH

Sec. 14 **KANSAS** Twp. 10 R. 19W **Rooks**

Well No. #1 Vohs "V" Farm \_\_\_\_\_  
Darby-Bothwell Company \_\_\_\_\_

**Zurick Bothwell**


\_\_\_\_\_ Ft. from N. Line

330 Ft. from S. Line

\_\_\_\_\_ Ft. from E. Line

990 Ft. from W. Line

**SW SE SE**

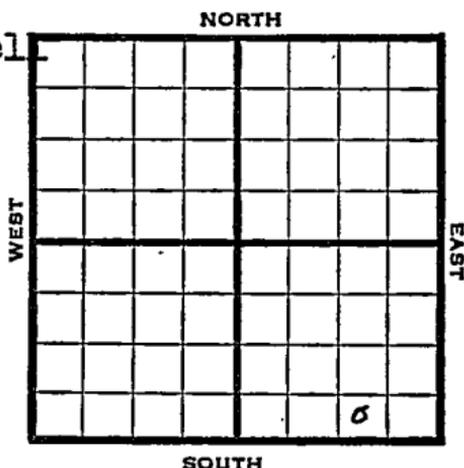

1947

Elev. 2039 **REPORT**

11/5

Location

11/12

8" @ 1414'  
WOC

11/19

Topeka 2984'  
Lansing 3231'  
Drig. 3366'

11/25

Conglomerate 3472'  
Simpson-sand 3535'  
Arbuckle 3569-75'  
TD 3575'  
5" @ 3570'  
RUST

12/3

"

12/10

Plug 3396'  
36 shots. 3268-80' - 3500 acid.  
Swb.  $\frac{1}{2}$  bbls. oil &  $\frac{1}{2}$  W PH  
33 shots 3253-64'  
3 shots. 3284-86' - 5000 acid.

12/17

Arbuckle 3569'  
TD 3575'

**ABANDONED**

Map No. \_\_\_\_\_ Sec. 14 Twp. 10- R. 19W

Well No. 1 Vohs "V"

Darby-Bothwell Company

FIRST REPORT

Contractor

SW SE SE

SECTION PLAT

\_\_\_\_\_ Ft. from N. Line

330 Ft. from S. Line

\_\_\_\_\_ Ft. from E. Line

990 Ft. from W. Line


Rooks County

Location X

Rig up \_\_\_\_\_

Drilling and Remarks:

RECORD

Cased \_\_\_\_\_ in., \_\_\_\_\_ ft.

Sand \_\_\_\_\_

Gas \_\_\_\_\_

Oil \_\_\_\_\_

Total Depth \_\_\_\_\_

PRODUCTION

1st 24 hrs. Nat. \_\_\_\_\_

1st 24 hrs. after shot \_\_\_\_\_

Gas \_\_\_\_\_ Cu. Ft.

Dry Hole \_\_\_\_\_

Abandoned \_\_\_\_\_

Date

NOV 5 1947 19

S. J. LEWIS Scout

65 Kansas

Map No. \_\_\_\_\_ Sec. 14 Twp. 10 R. 19W

Well No. 1 Vohs "B"

Darby Bothwell Company

ABANDONED Contractor

SW SE SE

E12089

SECTION PLAT

\_\_\_\_\_ Ft. from N. Line  
 330 Ft. from S. Line  
 \_\_\_\_\_ Ft. from E. Line  
 990 Ft. from W. Line

			0

Rooks County

Location \_\_\_\_\_  
 Rig up \_\_\_\_\_  
 Drilling and Remarks:

*See 8569*

RECORD

Cased \_\_\_\_\_ in., \_\_\_\_\_ ft.  
 Sand \_\_\_\_\_  
 Gas \_\_\_\_\_  
 Oil \_\_\_\_\_  
 Total Depth *3575*

PRODUCTION

1st 24 hrs. Nat. \_\_\_\_\_  
 1st 24 hrs. after shot \_\_\_\_\_  
 Gas \_\_\_\_\_ Cu. Ft.  
 Dry Hole \_\_\_\_\_  
 Abandoned \_\_\_\_\_

Date

DEC 17 1947

19

S. J. LEWIS

Scout