

Rooks


KANSAS

SECTION 14 TOWNSHIP 10 RANGE 20W

WELL NO. #8 Eliza

COMPANY Nadel & Gussman

NORTH

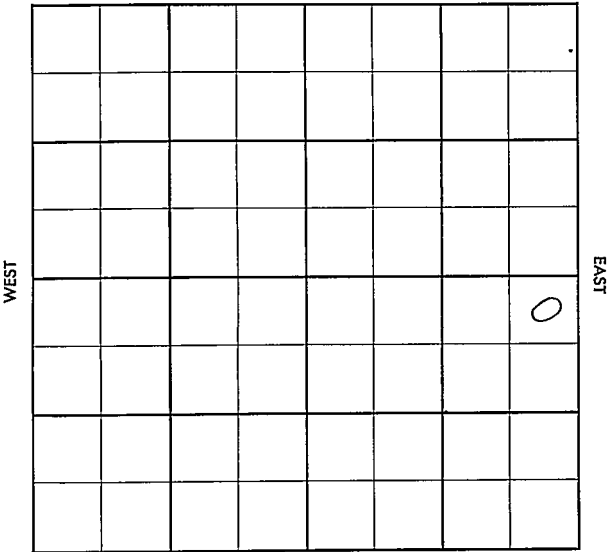

Rooks

KANSAS

SEC.

TWP.

R.

14

10

20W

WELL NO.

#8 Eliza

FARM

COMPANY

Nadel & Gussman

CONTRACTOR

Co. Tools

Marcotte


Ft. from N. Line

Ft. from S. Line

Ft. from E. Line

Ft. from W. Line

NE NE SE

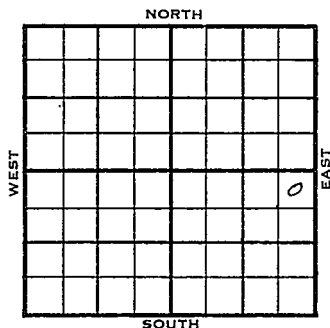

1956

ELEVATION

2182'

REPORT

5-16

Comm. 5-11-56
 8" @ 176 w/150
 Drlg. 2110'

7-11

DST 3575-91 op 1 hr., # 390' GIP, rec.
 690' clean oil, 790/20".
 DST 3597-3610 op 2 hrs., 120' GIP, rec.
 55' VHOCM, 120/20".
 5 1/2" @ 3720 w/100
 P/ 132 BOPD / 35% ?
 H. 3394'; L. 3431'; A. 3719';
 TD 3721'

COMPLETED

County Rocks Elev. _____
 Sec. 11 Twp. 10N Rge. 20W
 Company Nadel & Gussman
 Farm Name Eliza No. 8

TOPS ^e	DEPTH	LOG	DATUM	Loc. in Sec.
Anh.				NE NE SE
TP.				
H.				
Tr.				
Dg.				
Bl.				
L.				Geol.
K.C.				Contr.
B.K.C.				Co. tools
Ce.				Pool <u>Click</u>
C.				<u>Marcotte</u>
M.				
M.				
K.				
Mz.				
Mq.				
V.				
S.				
S.				
A.				
R.				
PE.				
G.				
T.D.				

Date Comm. 5-11-56
8" @ 176/150 drlg. 2110

8221 S S YAM

WAYS 78
 FIRST REPORT

County Rooks Elev. 2182
 Sec. 14 Twp. 10 Rge. 20W
 Company Nadel & Cushman
 FarmName Eliza No. 8

TOPS	DEPTH	LOG	DATUM	Loc. in Sec.
Anh.				NE NE SE
TP.				
H.	3394			200N
Tc.				
Dg.				
Bl.				
L.	3431			Geol.
K.C.				Contr.
B.K.C.				Co's tools
Ce.				Pool <u>Glick</u>
C.				<u>Marcotte</u>
M.				
M.				
K.				
Mz.				
Mo.				
V.				
S.				
S.				
A.	3719			
R.				
PE.				
G.				
T.D.	3721			

COMPLETE

Date Comm. 5-11-56 JUL 1 1 1956

8" @ 176/150 drlg, 2110 MAY 23 '56

DST 3575-91 1/4 390' GIP run

690' clean oil 790/20 DST

3597-3610 2 hrs 26 120' GIP run

55' V40CM 120/20 5 1/2 @ 3720/100

MAY 29 '56 JUN 6 '56 40 gal JUN 12 '56 JUN 20 '56

CO 3721 POP.

Ph P. 132 Bopd + 35% JUN 27 '56