


Rooks KANSAS

Section 14 Township 10 Range 20 WWell No. # 4 SutorCompany I. O. Miller

Rooks

KANSAS

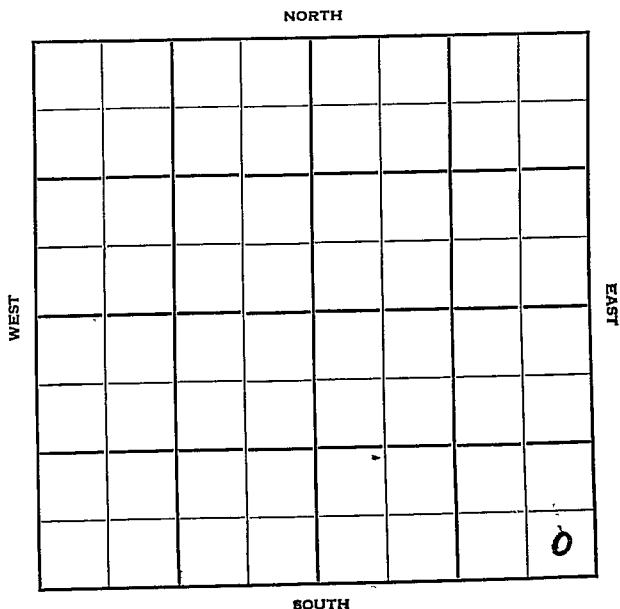

Sec. 14 Twp. 10 R. 20W

Well No. #4 Sutor Farm

I. O. Miller Company

Contractor


Ft. from N. Line

330' Ft. from S. Line

330' Ft. from E. Line

Ft. from W. Line

SE SE SE

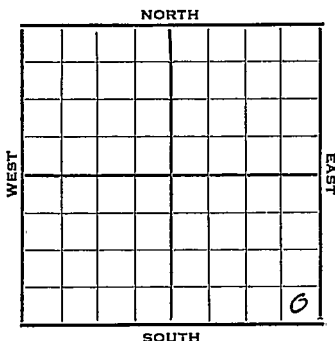

1952 Elev. 2212' REPORT

5/14 Spud 5-12-52
8" @223'

5/21 Anhy 1650 Drlg. 3314

5/28 Arb. 3767' Pipe set.

6/11 RTD 3770 5" @ 3769 CO 3770
500 A S/22 BOPH POP

6/18 NR

6/25 Spud 5-12-52
Oil Well TD 3770' 8" @ 223
Anhy 1650 Heeb. 3439
Tor. 3460 Lans. 3478
B KC 3701 $\frac{1}{2}$ Cong. 3724
Arb. 3767
TD 3770 5" @ 3769 CO to 3770
500 A S/ 22 boph
Comp. 414 bopd

COMPLETED



Sec. **14** (Blk. Twp.) **10** (Sur. Rge.) **20W** Map No.

Well No. 4 Farm Sutor

Elev.	Location	SE SE SE
-------	----------	----------

FIRST REPORT

330 Ft. From S Line SE

330 Ft. From E Line Quarter

1st. Report MAY 14 1952

Completion

Remarks


Spudding Date **5-12-52**

Drlg. Data

8th @ 223

J. G. McGEHEE

County _____ Rocks _____ State Kansas
 Sec. 14 (Blk. 10) (Sur. 20W) Map No. _____
 Operator I. O. Miller
 Well No. 4 Farm Sutor
 Elev. 2212 Location SE SE SE

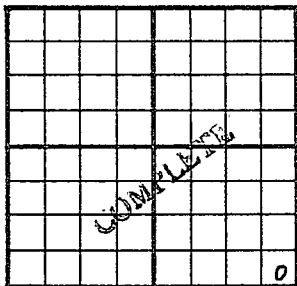

330 Ft. From S Line SE
330 Ft. From E Line Quarter
 Ist. Report _____
 Completion JUN 25 1952
 Remarks _____

Spudding Date 5-12-52

Drlg. Data Oil well TD 3770

8" @ 223 Anhy 1650 Heeb. 3439

Tor. 3460 Lans. 3478 B KC 3701

Cong. 3724 Arb. 3767 TD 3770

5" @ 3769 CO to 3770 500 A

S/ 22 boph Comp. 414 bopd

J. G. McGENEE