


Section 14 Township 10 Range 20W

Well No. 1 Sithem

Company Ted Ferrier

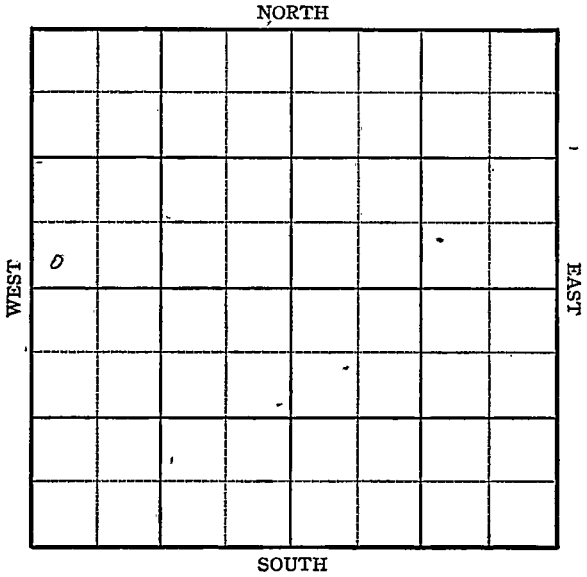

Sec. 14 Twp. 10 R. 20-W

Well No. #1 Sithem Farm _____


Ted Ferrier Company _____

_____ Ft. from N. Line

330 Ft. from S. Line

_____ Ft. from E. Line

330 Ft. from W. Line

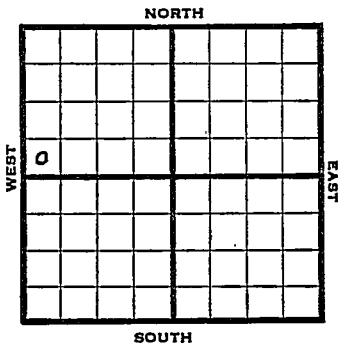

SW NW Elev. 2226

1945

REPORT

9/12 RUR

9/19 10" @ 200
Drlg. 1320'

9/26 Anhy. 1436
Drlg. 2642

10/3 Lans 3486
Arb. 3785 SO
TD 3790

5" @ 3787' RUST

10/10 " " "

10/17 TD 3826
1 WPer hr. PB

10/24 Arb. 3816 corrected
5" @ 3787
TD 3826'

ABANDONED

KANSAS

Kansas

Pool Name WildcatMap No. 65 Sec. 14 Twp. 10 R. 20WWell No. 1 Sithem

Ted Ferrier

Company

ABANDONED

Contractor

SW NW

E1. 2226
SECTION PLAT

_____ Ft. from N. Line

330 Ft. from S. Line

_____ Ft. from E. Line

330 Ft. from W. Line

Rooks County

Location _____

Rig up _____

Drilling and Remarks:

*Per #38716 corrected
5" @ 3787.*

RECORD

Cased _____ in., _____ ft.

Sand _____

Gas _____

Oil _____

Total Depth 3826

PRODUCTION

1st 24 hrs. Nat. _____

1st 24 hrs. after shot _____

Gas _____ Cu. Ft.

Dry Hole _____

Abandoned _____

Date

OCT 24 1945 19

S. J. LEWIS

Scout