

Section 14 Township 10 Range 20W

Well No. 1 Sithem

Company Nadel & Gussman

Wildcat

NORTH

							0

WEST

EAST

SOUTH

KANSAS

Rooks



Sec. 14 Twp. 10 R. 20W

Well No. #1 Sithem Farm

Nadel & Gussman Company

Wildcat


330' Ft. from N. Line

_____ Ft. from S. Line

330' Ft. from E. Line

_____ Ft. from W. Line

NE/C

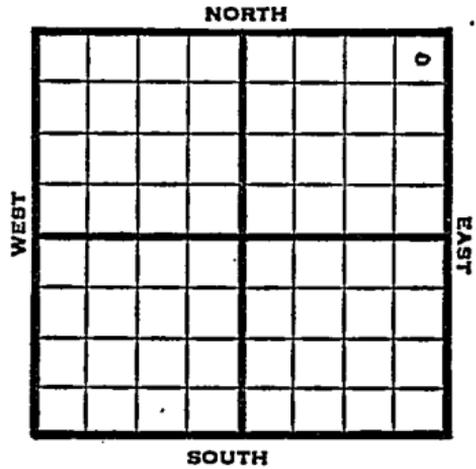

1949

Elev. 2202' REPORT

1/12
1/19

Surface Hole
10" @ 191'
Drlg 3072'

1/26

Arbuckle 3778'
Clay 3795'
TD 3852 in Chert
ABANDONED

Map No. _____ Sec. 14 Twp. 10 R. 20W

Well No. 1 Sithem

Nadel & Gussman Company

FIRST REPORT Contractor

NE/C


SECTION PLAT

330 Ft. from N. Line

Ft. from S. Line

330 Ft. from E. Line

Ft. from W. Line

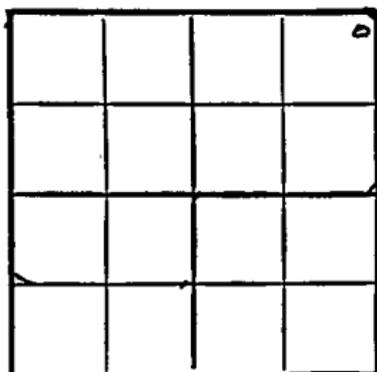

Rooks County

RECORD

Location _____

Cased _____ in., _____ ft.

Rig up _____

Sand _____

Drilling and Remarks:

Gas _____

surface hole

Oil _____

Total Depth _____

PRODUCTION

1st 24 hrs. Nat. _____

1st 24 hrs. after shot _____

Gas _____ Cu. Ft.

Dry Hole _____

Abandoned _____

Date

JAN 12 1949 19

S. J. LEWIS Scout

Kansas

Map No. 65 Sec. 14 Twp. 10 R. 20W

Well No. 1 Sithem

Nadel & Gussman Company

ABANDONED

Contractor

NE/C

E12202

SECTION PLAT

330 Ft. from N. Line

 Ft. from S. Line

330 Ft. from E. Line

 Ft. from W. Line

			6

Rooks County

Location _____

Rig up _____

Drilling and Remarks:

Recut 8775
Clay 8795

RECORD

Cased _____ in., _____ ft.

Sand _____

Gas _____

Oil _____

Total Depth 3752 in. Check

PRODUCTION

1st 24 hrs. Nat. _____

1st 24 hrs. after shot _____

Gas _____ Cu. Ft.

Dry Hole _____

Abandoned _____

Date

JAN 26 1949

19

S. J. LEWIS

Scout