

Section 14 Township 10 Range 20WWell No. #2
#3 StithemCompany Nadel & Gussman

NORTH

		0					

WEST

EAST

SOUTH

Rooks KANSAS

Sec. 14 Twp. 10 R. 20 W ✓

Well No. #2
#3 Stithem Farm

Nadel & Gussman Company

Contractor

Marcotte Pool


330 Ft. from N. Line

Ft. from S. Line

990 Ft. from E. Line

Ft. from W. Line

NW NE NW

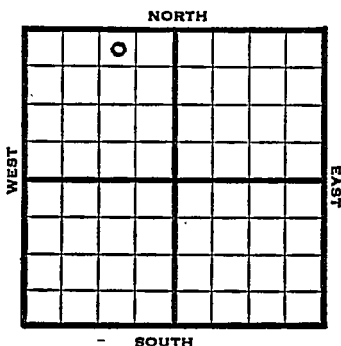

1951

Elev. 2239'

REPORT

3/14

Location

5/2

Oil well TD 3787'
Heeb 3460' Lans 3499' Arb 3784'
TD 3787' S/13 BOPH 1000 A
Comp. deptho. pot. 1423 BOPD

COMPLETED

County Rooks State KansasSec. 14 (Blk.
Twp.) 10 (Sur.
Rge.) 2 OW Map No.Operator Nadel & GussmanWell No. 3 Farm StithemElev. _____ Location NW NE NW

		0				

330 Ft. From N Line NW990 Ft. From E Line Quarter1st. Report MAR 14 1951CompletionRemarksSpudding DateDrilg. Data Marcotte PoolLocation

J. E. TYRA

Kansas

Map No. _____ Sec. 14 Twp. 10 R. 20WWell No. 2 StithemNadel & Gussman

Company

CORRECTION

Contractor

NW NE NW


SECTION PLAT

330 Ft. from N. Line

_____ Ft. from S. Line

990 Ft. from E. Line

_____ Ft. from W. Line

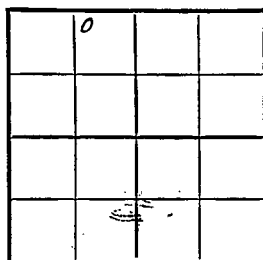

Rooks County

Location _____

Rig up _____

Drilling and Remarks:

Reported

#3 Stithem

RECORD

Cased _____ in., _____ ft.

Sand _____

Gas _____

Oil _____

Total Depth _____

PRODUCTION

1st 24 hrs. Nat. _____

1st 24 hrs. after shot _____

Gas _____ Cu. Ft.

Dry Hole _____

Abandoned _____

Date

APR 25 1951

19

J. E. TYRA

Scout

County Rooks State Kansas
 Sec. 14 (Blk. 10 (Sur. 20W Map No.
 (Twp.) (Rge.)
 Operator Nadel & Gussman
 Well No. 2 Farm Stithem
 Elev. 2239 Location NW NE NW

		0				

COMPLETE

330 Ft. From N Line NW
990 Ft. From E Line Quarter
 Ist. Report
 Completion MAY 2 1951
 Remarks Marcotte Pool

Spudding Date

Drig. Data Oil well TD 3787
Heeb. 3460 Lans. 3499 APb. 3784
TD 3787 S/ 13 boph 1000 A
Comp. deptho. pot. 1423 bopd

J. E. TYRA