

Section 14 Township 10 Range 20W

Well No. #16 Stithem

Company Nadel & Gussman

NORTH

	8 02						

WEST

EAST

SOUTH

Rooks

KANSAS

Sec. 14 Twp. 10 R. 20 W

Well No. # 16 Stithem Farm

Nadel & Gussman Company

Contractor

730 Ft. from N. Line


2640 Ft. from S. Line

1550 Ft. from E. Line

990 Ft. from W. Line

NE NW SW

~~C E/2 W/2 W/2~~

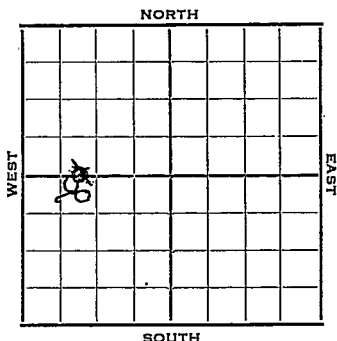

2239' corr.

Elev. 2240' REPORT

1952

6/11 Location

6/18 10" @ 160

Anhy 1669' Drlg. 1675'

6/25 Drlg. 3345'

7/2 Heeb. 3464 Lans. 3503

Arb. 3788 RTD 3791

5" @ 3786 DP 3791 250 A

7/9 S/4 BFPH 50% wtr tub & rods

7/17 DD 3793 TD S/2 BO & 2 BWPH POP

7/23 NR

7/30 NR

8/6 Spud 6-14-52

Oil well TD 3793' 10" @ 160

Anhy 1669' Heeb 3464' Lans. 3503'

Arb. 3788' TD 3791' 5" @ 3786'

DP to 3791 250 A S/4 BFPH 50% wtr.

DD 3793' S/2 BOPH 2 BW

Comp. 81 BOPD 70% water.

COMPLETED

County

Rocks

State KANSAS

Sec. 14

(Blk.)
(Twp.)

10

(Sur.)
(Rge.)

20W

Map No.

Operator

Nadel & Gussman

Well No.

16

Farm

Stithem

Elev.

2240

Location

C E¹ W¹ W¹

0

FIRST REPORT

2640 Ft. From

S Line

Sec.

990Ft. From

W Line

Quarter

1st. Report

JUN 11 1952

Completion

Remarks

Spudding Date

Drig. Data

Location

J. G. McGEHEE

Rooks

Kansas

Map No. _____ Sec. 14 Twp. 10 R. 20W

Well No. 16 Stithem

Nadel & Gussman Company

CORRECTION Contractor

NE NW SW

SECTION PLAT

230 Ft. from N. Line

_____ Ft. from S. Line

1550 Ft. from E. Line

_____ Ft. from W. Line

0			

Location _____

Rig up _____

Drilling and Remarks:

Reported

$CE\frac{1}{2}$ $W\frac{1}{2}$ $W\frac{1}{2}$ Sec. _____

RECORD

Cased _____ in., _____ ft.

Sand _____

Gas _____

Oil _____

Total Depth _____

PRODUCTION

1st 24 hrs. Nat. _____

1st 24 hrs. after shot _____

Gas _____ Cu. Ft.

Dry Hole _____

Abandoned _____

Date

JUN 25 1952

19

J. G. McGEHEE

Scout

J. G. McGEHEE