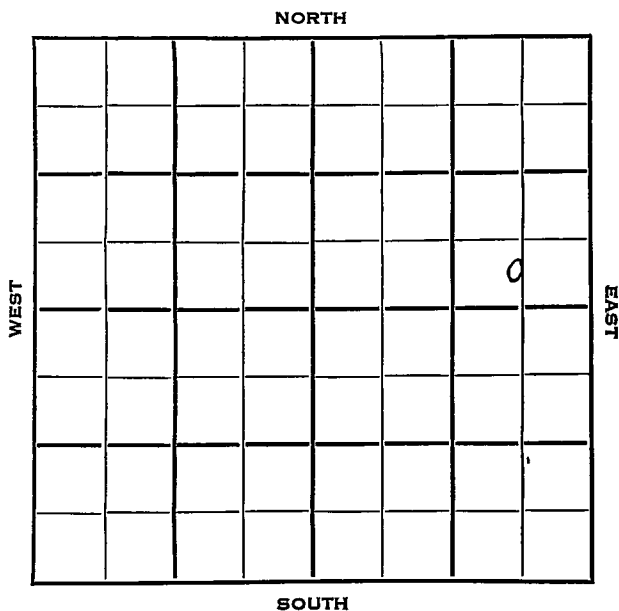


Section 14 Township 10 Range 20 WWell No. # 18 StithamCompany Nadel & Gussman

Rooks **KANSAS**

SEC.	TWP.	R.
14	10	20 W ✓

WELL NO. _____

COMPANY # 18 Stitham FARM

CONTRACTOR Nadel & Gussman

Re-serve Drlg.


_____ Ft. from N. Line

330 _____ Ft. from S. Line

_____ Ft. from E. Line

1800 _____ Ft. from W. Line

C S L SE NE

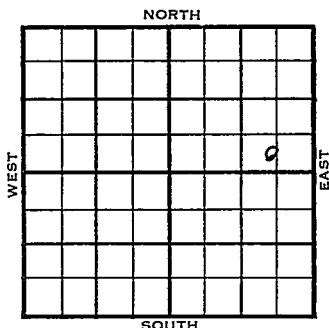

	ELEVATION	REPORT
1954	2206'	
3/24	Spud 3-18-54 10" @ 130 Anhy 1651 Drlg. 2486'	
4/28	Spud 3-18-54 Oil Well TD 3744' 10" @ 130' Anhy 1651'; Heeb 3423'; Lans 3461'; Cong 3691'; Simp. 3734'; Arb. 3741' TD 3744' 5" @ 3742' CO to 3744' FU 1000' oil 1 hr. S/52 boph Uomp. 3000 bopd	COMPLETED

County	Rooks	State	Kansas
--------	-------	-------	--------

Sec. 14 (Blk. Twp.) 10 (Sur. Rge.) 20W Map No.

Operator **Nadel & Gussman**

Well No. **18** Farm **Stitham**

Elev. 2206 Location C S L SE NE

0

FIRST REPORT

330 Ft. From S Line NE

1800 Ft. From W Line Quarter

1st. Report **MAR 24 1954**

Completion

Remarks


Reserve Drlg. - Contr.

Spudding Date **3-18-54**

Drlg. Data

10% @ 130 Anby 1651 drlg. 2486

County _____ Rooks _____ State **Kansas**
 Sec. **14** (^{Blk.}_{Twp.}) **10** (^{Sur.}_{Rge.}) **20W** Map No. _____
 Operator **Nadel & Gussman**
 Well No. **18** Farm **Stitham**
 Elev. **2206** Location **C S L SE NE**

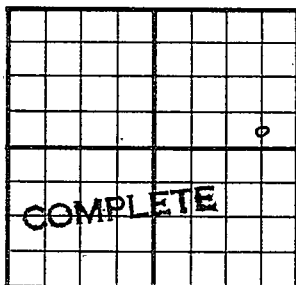

330 Ft. From S Line NE
1800 Ft. From W Line Quarter

1st. Report _____

Completion **APR 2-8 1954**

Remarks _____

Reserve Drlg. - Contr.

Spudding Date **3-18-54**

Drlg. Data **Oil well TD 3744**

10" @ 130 Anhy 1651 Heeb. 3423

Lans. 3461 Cong. 3691 Simp. 3734

Arb. 3741 TD 3744 5" @ 3742 CO to 3744

FU 1000' oil 1 hr. S/ 52 boph

Comp. 3000 bopd

J. G. McGEHEE