


Section 14 Township 10 Range 20WWell No. #13 StithemCompany Nadel & Gussman

NORTH

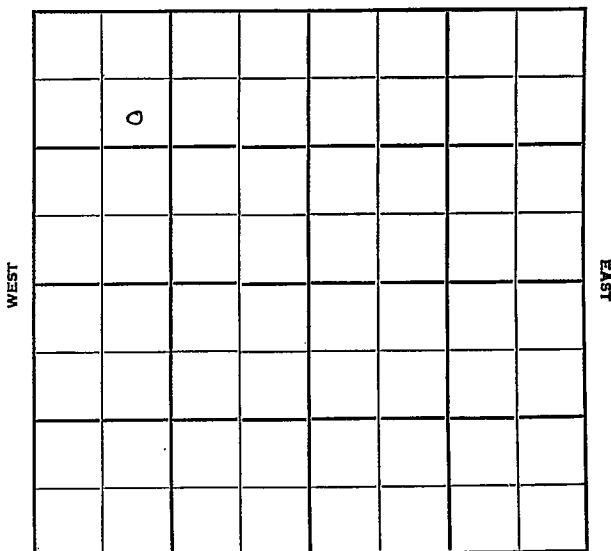

SOUTH

Rooks

KANSAS

Sec. 14 Twp. 10 R. 20 W ✓

Well No. # 13 Stithem Farm

Nadel & Gussman Company

Reserve Contractor


990 Ft. from N. Line

 Ft. from S. Line

 Ft. from E. Line

990 Ft. from W. Line

SE NW NW

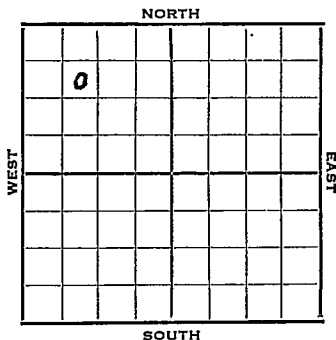

1952 Elev. 2235' REPORT

4/2 Spud 3-28-52
10" @ 148
Anhy 1671'
Drlg. 2445'

4/9 Heeb. 3454 Tor. 3473
Lans. 3493 B KC 3707
Cong. 3742 Simp shal 3770
Arb. 3776 RTD 3780
5" @ 3776' WOC


4/23 DP to 3780' Fill up 1200' oil 1 hr.
S/70 BOPH

5/7 Spud 3-28-52
Oil well TD 3780' 10" @ 148
Anhy 1671' Heeb 3454' Tor. 3473'
Lans. 3493' B KC 3707' Cong. 3742'
Simp. 3770' Arb. 3776'
TD 3780' 5" @ 3776 DP to 3780
FU 1200' oil 1 hr. S/70 BOPH
500 A
Comp. KFL 4507 BOPD

COMPLETED

J. G. McGEHEE

County Rooks State Kansas
 Sec. 14 (Blk. 10 (Sur. 20W Map No.
 Operator Nadel & Gussman
 Well No. 13 Farm Stithem
 Elev. 2235 Location SE NW NW

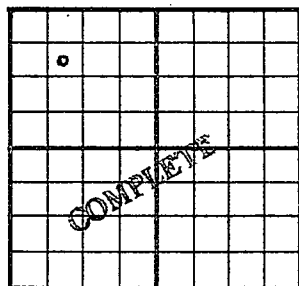

990 Ft. From N Line NW
990 Ft. From W Line Quarter
 Ist. Report
 Completion MAY 7 1952
 Remarks
Reserve Drlg. - Cont
 Spudding Date 3-28-52

Drlg. Data Oil well TD 3780
10" @ 148 Anhy 1671 Heeb. 3454
Tor. 3473 Lans. 3493 B KC 3707
Cong. 3742 Simp. 3770 Arb. 3776
TD 3780 5" @ 3776 DP to 3780
FU 1200' oil 1 hr. S/ 70 boph
500 A Comp. KFL 4507 bopd

J. G. McGEHEE