

Section 14 Township 10 Range 20 WWell No. # 13 StithemCompany Nadel & Gussman

NORTH

	0						

WEST

EAST

SOUTH

Rooks

KANSAS

Sec. 14 Twp. 10 R. 20W

Well No. #13 Stithem Farm

Nadel & Gussman Company

Contractor

Marcotte Pool


990 Ft. from N. Line

_____ Ft. from S. Line

_____ Ft. from E. Line

990 Ft. from W. Line

SE NW NW

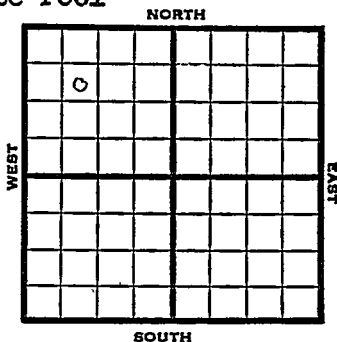

1951

REPORT

10/3

Location

10/10

Abandoned Location

ABANDONED

County **Rooks** State **Kansas**

Sec. 14 (Blk. Twp.) 10 (Sur. Rge.) 20W Map No.

Operator **Nadel & Gussman**

Well No. 13 Farm Stithen

Elev.	Location	SE	NW	NW
-------	----------	----	----	----

[illegible]

990 Ft. From N Line NW

990 Ft. From ~~FF~~ Line Quarter

1st. Report OCT 3 1951

Completion

Remarks

Spudding Date _____

Drig. Data Marcotte Pool

Location

J. E. TYKA

County _____ Rooks _____ State KansasSec. 14 (Blk.
Twp.) 10 (Sur.
Rge.) 20W Map No. _____Operator Nadel & GussmanWell No. 13 Farm StithemElev. _____ Location SE NW NW

0					

990 Ft. From N Line NW990 Ft. From W Line Quarter1st. ReportCompletion OCT 10 1951Remarks Marcotte PoolSpudding DateDrlg. DataAbd. location