

KANSAS

Graham

21W ✓

Sec. 14 Twp. _____ R. _____

Well No. #1 Acheson Farm _____

Skelly Company


Moran Pool

_____ Ft. from N. Line

330' Ft. from S. Line

_____ Ft. from E. Line

330' Ft. from W. Line

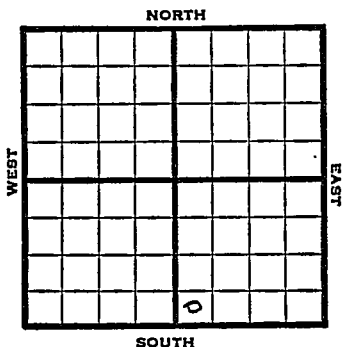

SW SE

1949

Elev 2181' R E P O R T

4/27 Location
5/4 8" @ 302'
5/10 Drlg 3300
5/18 Lans 3436'
Arb. 3740-43'
TD 3743'
5" @ 3741'
5/25 TD 3749'
Arb. 3740'
5" @ 3741'
500 acid
Pump 514 Oil Pot
27° Gr.
Comp

COMPLETED

Map No. _____ Sec. 14 Twp. 10 R. 21W

Well No. 1 Acheson

Skelly Company

FIRST REPORT

Contractor

SW SE

SECTION PLAT

_____ Ft. from N. Line

330

_____ Ft. from S. Line

_____ Ft. from E. Line

330

_____ Ft. from W. Line

Graham County

Location X

Rig up _____

Drilling and Remarks:

RECORD

Cased _____ in., _____ ft.

Sand _____

Gas _____

Oil _____

Total Depth _____

PRODUCTION

1st 24 hrs. Nat. _____

1st 24 hrs. after shot _____

Gas _____ Cu. Ft.

Dry Hole _____

Abandoned _____

Date

APR 27 1949 19

S. J. LEWIS Scout

Kansas

Moran Pool

Map No. K65 Sec. 14 Twp. 10 R. 21WWell No. 1 Acheson

Skelly

Company

COMPLETE

Contractor

SW SE

E 1, 2, 3, 4

SECTION PLAT

_____ Ft. from N. Line

330 Ft. from S. Line

_____ Ft. from E. Line

330 Ft. from W. Line

Graham County

Location _____

Rig up _____

Drilling and Remarks:

Cur 37405" @ 3741500 acidRun 514 oil27° SW

RECORD

Cased _____ in., _____ ft.

Sand _____

Gas _____

Oil _____

Total Depth 3749

PRODUCTION

1st 24 hrs. Nat. _____

1st 24 hrs. after shot _____

Gas _____ Cu. Ft.

Dry Hole _____

Abandoned _____

Date

MAY 25 1949 19

S. J. LEWIS

Scout