

Graham

FORM 51


KANSAS

Section 14 Township 10 Range 21W

Well No. #6 Acheson

Company Jones, Shelburne & Farmer

NORTH

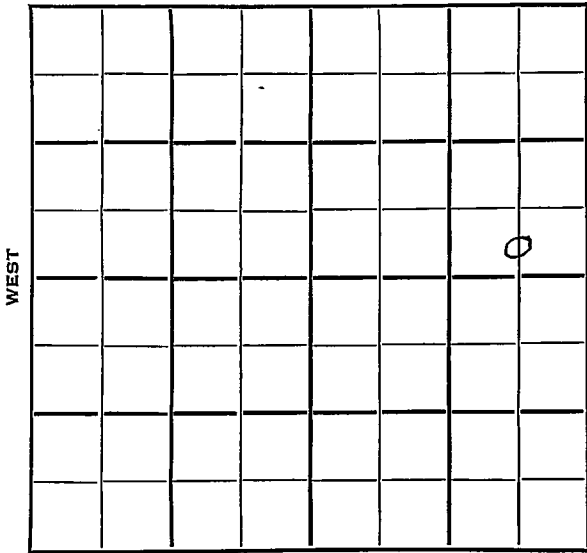

SOUTH

WEST

EAST

8

0

Graham

KANSAS

SEC.	TWP.	R.
14	10	21 W

WELL NO.

6 Acheson

FARM

COMPANY

Jones, Shelburne & Farmer

CONTRACTOR

J-S-F


_____ Ft. from N. Line

330 _____ Ft. from S. Line

660 _____ Ft. from E. Line

_____ Ft. from W. Line

C S L SE NE

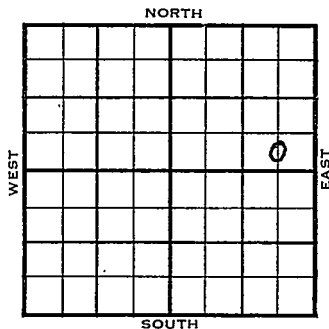

1954	ELEVATION	REPORT
	2243'	

1/6	Location
1/13	8" @ 160 Any 1700' Drlg. 2425'
1/20	Heeb 3448', Tor 3473', Lans 3487' DST 3650-70', 1 hr., 960' gas, 2550' free oil, 1300# B KC 3710', Cong 3773', Arb. 3789' RTD 3793' 5" @ 3790'
1/27	CO 3793' S/20 BFPH 60% oil
2/3	NR
2/10	NR
3/10	"
4/28	Spud 1-9-54 Oil Well TD 3793' 8" @ 160' Any 1700', Heeb 3448', Tor 3473', Lans 3487' DST 3650-70', opn 1 hr., rec. 960' gas, 2550' free oil, 1300# B KC 3710', Cong 3773', Arb. 3789' TD 3793' 5" @ 3790' CO to 3793, S/20 bfp 60% oil, P 54 bo 200 bwpd Comp. 40 bopd 190 bw COMPLETED

