

Section 14 Township 10 Range 21W

Well No. 1 Lewis

Company Anderson & Prichard

Moran

NORTH


14

WEST

EAST

SOUTH

0

KANSAS

Graham

Sec. 14 Twp. 10 R. 21W ✓

Well No. #1 Lewis Farm

Anderson & Prichard Company


Moran

\_\_\_\_\_ Ft. from N. Line

330' Ft. from S. Line

330' Ft. from E. Line

\_\_\_\_\_ Ft. from W. Line

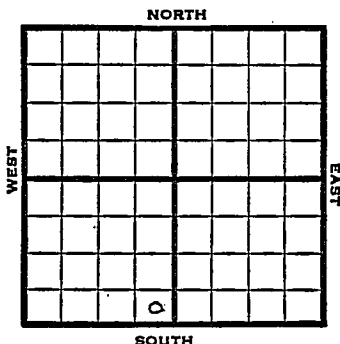

SE SW

1949 Elev 2211' REPORT

2/9 8" @ 277'  
 2/16 DrLg 3105'  
 2/23 Lansing 3466'  
 Arb. 3770'  
 TD 3775  
 5" @ 3662'  
 3/2 "  
 3/8 TD 3780'  
 500 acid  
 Swb 42 bbls oil PH 5 hrs.  
 3/16 "  
 3/23 Pump 208 bbls oil 24 hrs.  
 3/30 "  
 4/6 "  
 4/13 TD 3780'  
 Arb. 3770'  
 5" @ 3662'  
 500 acid  
 Pump 414 Oil Pot  
 29° Gr.  
 Comp  
**COMPLETED**

*Moran*

Map No. \_\_\_\_\_ Sec. 14 Twp. 10 R. 21W

Well No. 1 Leased

Anderson & Prichard Company

**FIRST REPORT**

Contractor

SESW

**SECTION FLAT**


\_\_\_\_\_ Ft. from N. Line

330 Ft. from S. Line

330 Ft. from E. Line

\_\_\_\_\_ Ft. from W. Line

Yarabians

Location \_\_\_\_\_

Rig up \_\_\_\_\_

Drilling and Remarks:

8" @ 277'

**RECORD**

Cased \_\_\_\_\_ in., \_\_\_\_\_ ft.

Sand \_\_\_\_\_

Gas \_\_\_\_\_

Oil \_\_\_\_\_

Total Depth \_\_\_\_\_

**PRODUCTION**

1st 24 hrs. Nat. \_\_\_\_\_

1st 24 hrs. after shot \_\_\_\_\_

Gas \_\_\_\_\_ Cu. Ft.

Dry Hole \_\_\_\_\_

Abandoned \_\_\_\_\_

Date

FEB 9 1949 19

S. J. LEWIS Scout

