

KANSAS

Graham

Sec. 14 Twp. 10 R. 21W ✓

Well No. #2 Lewis Farm

Anderson-Prichard Company


Moran Pool

_____ Ft. from N. Line

990' Ft. from S. Line

990' Ft. from E. Line

_____ Ft. from W. Line

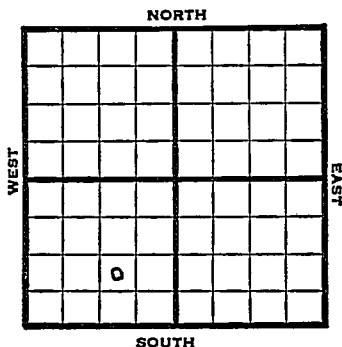

NW SE SW

1949

Elev 2001' REPORT

4/20

RUR

4/27

10" @ 275'

Drlg 2615'

5/4

Lansing 3472'

Drlg 3789'

5/11

TD 3816'

Cong 3747'

Arb. 3802'

Aband.

ABANDONED

Map No. _____ Sec. 14 Twp. 10 R. 21W

Well No. 2 Lewis

Anderson-Prichard Company

FIRST REPORT

Contractor

NW SE SW

SECTION PLAT

_____ Ft. from N. Line

990 Ft. from S. Line

990 Ft. from E. Line

_____ Ft. from W. Line

Graham County

Location _____

Rig up _____

Drilling and Remarks:

R U R

RECORD

Cased _____ in., _____ ft.

Sand _____

Gas _____

Oil _____

Total Depth _____

PRODUCTION

1st 24 hrs. Nat. _____

1st 24 hrs. after shot _____

Gas _____ Cu. Ft.

Dry Hole _____

Abandoned _____

Date

APR 20 1949 19

S. J. LEWIS

Scout

