

Section 14 Township 10 Range 21 WWell No. #1 MORLAN SWD
#3 AchesonCompany Skelly Oil et al

NORTH

WEST

EAST

16

0

SOUTH

O. W. D. D. Graham

KANSAS

Sec. 14 Twp. 10 R. 21W

Well No. #1 MORLAN SWD
#3 Acheson Farm

Skelly Oil et al Company

Contractor

Morlan Pool


 Ft. from N. Line

330' Ft. from S. Line

330' Ft. from E. Line

 Ft. from W. Line

SE SE, SE

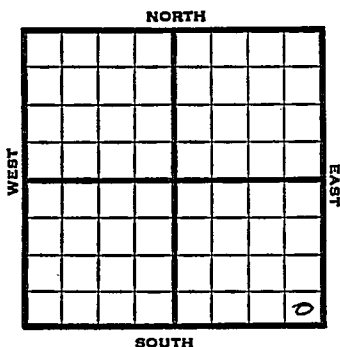

1951 Elv. 2191' REPORT

7/11 Spud 7-5-51
8" @ 309
Drlg. 1800'

8/15 Spud 7-5-51
Oil well TD 3784' 8" @ 309'
Heeb 3415' Lans 3455' Arb. 3754'
TD 3784' 5" @ 3784' CO to 3778
45/3762-67 FU 350' oil 1½ hr.
P/9 BO 4 hr. 250 A P/14 BO 14 hr.
SP 3758' 90/3746-56 FU 60' oil
300 A S/16 BO 3 hr. P/131 BO
1 BW 16 hr. 750 A S/86 BO 4 hr.
P/35 BO 1 BW 10 hr.
Comp. 83 BOPD 1% water

COMPLETED

O. W. D. D

1953
11/4

SWD Well
TD 4226'
Arb. 3746'
5" @ 3784'
OTD 3784' DD
Regan Sd 4206'-26', 3000A
Comp. for SWD Well
Input 178 bw in 35 mins.

FIRST REPORT
ABANDONED

County Graham State KansasSec. 14 (Blk.) 10 (Sur.) 21W Map No.
(Twp.) (Rge.)Operator Skelly OilWell No. 3 Farm AchesonElev. 2191 Location SE SE SE

							0

330 Ft. From S Line SE330 Ft. From E Line Quarter

1st. Report

Completion

Remarks

Spudding Date 7-5-51

Drlg. Data

Morlan - pool8" @ 309 Drlg. 1800J. E. TYRA

Sec. 14 (Blk. Twp.) 10 (Sur. Rge.) 21W Map No.

Well No. 3 Farm Acheson

Elev.	2191	Location	SE SE SE
-------	------	----------	----------

[illegible]

330 Ft. From S Line SE

330 Ft. From E Line Quarter

1st. Report

Completion AUG 15 1951

Remarks Morlan Pool

Spudding Date 7-5-51

Drilg. Data Oil well TD 3784

8" @ 309 Heeb. 3415 Lans. 3455

Arb. 3754 TD 3784 5" @ 3784 CO to 3778

45/ 3762-67 FU 350' oil $1\frac{1}{2}$ hr. P/ 9 bo

4 hr. 250 A ' P/ 14 bo 14 hr. SP 3758

90/ 3746-56 FU 60' oil 300 A

S/ 16 bo 3 hr. P/ 131 bo 1 bw 16 hr.


750 A S/ 86 bo 4 hr. P/ 35 bo 1 bw

10 hr. Comp. 83 bond. 1% water

J. E. TYRA

O. W. D. D

County Graham State Kansas
 Sec. 14 (Blk. 10) (Sur. 21W) Map No. 10
 Operator Skelly Oil et al.
 Well No. 1 Farm Morlan SWD (was #3 Acheson)
 Elev. 2191 Location SE SE SE

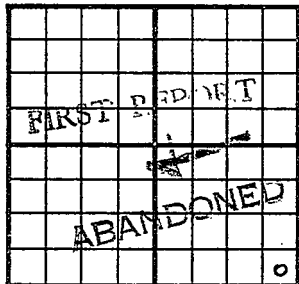

330 Ft. From S Line SE

330 Ft. From E Line Quarter

1st. Report NOV 4 1953

Completion NOV 4 1953

Remarks

OWDD

O. W. D. D

Spudding Date

Drig. Data SWD well TD 4226

Arb. 3746 5" @ 3784 OTD 3784 DB

Regan sd. 4206-26 3000 A

Comp. for SWD well Input 178 bw in 35 min.

J. G. McGEHEE