

Section 14 Township 10 Range 21 W

Well No. # 1 Acheson

Company Jones, Shelburne, & Farmer

NORTH

						.	
						o	

WEST

EAST

SOUTH

Sec. 14 Twp. 10 R. 21W

Well No. #1 Acheson Farm

Jones. Shelburne & Farmer Company

Contractor

Laura


Ft. from N. Line

990' Ft. from S. Line

990' Ft. from E. Line

Ft. from W. Line

NW SE NE

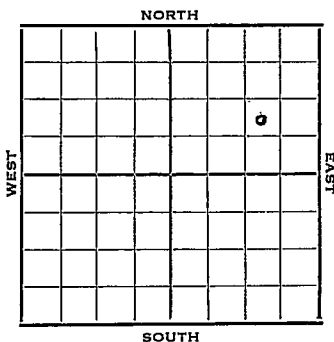

SOUTH

1952

Elev. 2255'

REPORT

2/27

Location

3/5

Drilg. 3000'

3/12

Heeb 3463' Tor. 3489' Lans. 3506'

DST 3667-80', 1/4 hr, 600' gas

90' HOCM, 240' clean oil 1240#

DST 3787-94, 1/2 hr, 370' clean oil,

150' OCM Arb. 3786' RTD 3794'

5" @ 3787 WOC

3/19

"

3/25

DP

4/1

PB 3794, fill up 1000' oil 3 hrs.

S/ 8 BOPH 500 A S/ 20 boph

800' off btm. POP

4/9

POP

4/23

P/265 BO 24 hrs.

4/30

NR

5/7

Spud 2-26-52

Oil well TD 3794' 8" @ 165

Anhy 1727' Heeb 3463' Tor. 3489'

Lans. 3506'

DST 3667-80 open 15 min, rec 600' gas

90' HOCM, 240' clean oil

DST 3787-94 open 1/2 hr, rec 370' clean

oil, 150' OCM.

Arb. 3786' TD 3794' 5" @ 3787

OVER

1952
5/7

(Information continued)

DP to 3794' FU 1000' oil 3 hr.

S/8 BOPH 500 A S/20 BOPH

S/20 BOPH P/265 BO

Comp. 364 BOPD

COMPLETED

County Graham State Kansas

Sec. 14 (Blk. Twp.) 10 (Sur. Rge.) 21W Map No.

Operator Jones, Shelburne & Farmer

Well No. 1 Farm Acheson

Elev. _____ Location NW SE NE

FIRST REPORT

990 Ft. From S Line NE

990 Ft. From E Line Quarter

1st. Report FEB 27 1952

Completion _____

Remarks _____

Spudding Date _____

Drlg. Data Laura

Location

J. G. McGEHEE

County Graham State Kansas
 Sec. 14 (Blk. Twp.) 10 (Sur. Rge.) 21W Map No.
 Operator Jones, Shelborne & Farmer
 Well No. 1 Farm Acheson
 Elev. 2255 Location NW SE NE

990 Ft. From S Line NE
990 Ft. From E Line Quarter
 Ist. Report _____
 Completion MAY 7 1952
 Remarks Laura Pool
 Spudding Date 2-26-52

Drlg. Data Oil well TD 3794
8" @ 165 Anhy 1727 Heeb. 3463
Tor. 3489 Lans. 3506 DST 3667-
80 ⁰ open 15 min. Rec. 600' gas
90' hocm 240' clean oil DST 3787-
94 open $\frac{1}{2}$ hr. Rec. 370' clean
oil 150' ocm Arb. 3786 TD 3794
5" @ 3787 DP to 3794 FU 1000'
oil 3 hr. S/ 8 boph 500 A
S/ 20 boph S/ 20 boph P/ 265 bo
Comp. 364 bopd