
FORM 51

Graham KANSAS

Section 14 Township 10 Range 21 W

Well No. # 5 Acheson

Company Jones, Shelburne & Farmer

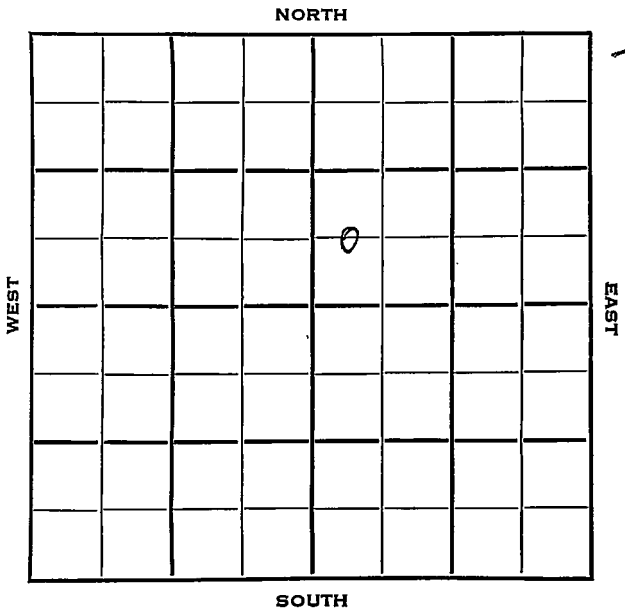

Graham KANSAS

SEC.	TWP.	R.
14	10	21W

WELL NO.

5 Acheson FARM

COMPANY

Jones, Shelburne & Farmer

CONTRACTOR


_____ Ft. from N. Line

660 Ft. from S. Line

_____ Ft. from E. Line

330 Ft. from W. Line

C W L SW NE

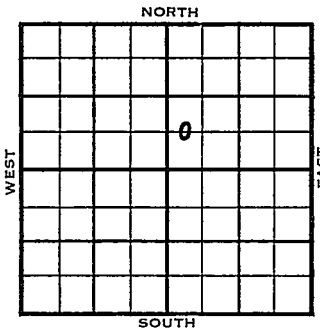

1953	ELEVATION 2192'	REPORT
12/16		Spud 12-14-53 8" @ 185' Anhy 1651' Drlg. 1770'
1954 1/6		Heeb 3396 Tor 3427' Lans 3443' B KC 3663' Simp 3721 Arb. 3732 RTD 3740' 5" @ 3734'
1/13		DD 3742' TD S/1½ BOPH 4 hrs. 1000 A S/12 BOPH 12 hrs. POP
1/20 2/3		NR Spud 12-14-53 Oil well TD 3742 8" @ 185 Anhy 1651 Heeb 3396 Tor. 3427 Lans 3443 B KC 3663 Simp. 3721 Arb. 3732 TD 3740 5" @ 3734 DD 3742 S/1½ BOPH 4 hr. 1000 A S/12 BOPH 12 hr. Comp. 265 BOPD COMPLETED

DX-78

FORM 275 FOR SALE BY KANSAS BLUE PRINT CO.


County Graham State Kansas

Sec. 14 (Blk. Twp.) 10 (Sur. Rge.) 21W Map No.

Operator Jones, Shelburne & Farmer

Well No. 5 Farm Acheson

Elev. Location C W L SW NE

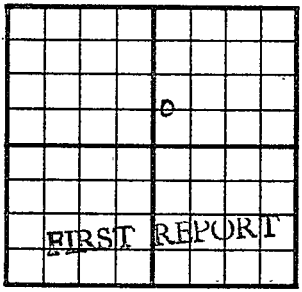

660 Ft. From S Line NE

330 Ft. From W Line Quarter

Ist. Report DEC 16 1953

Completion

Remarks

Spudding Date 12-14-53

Drlg. Data

8" @ 185 Anhy 1651 drlg. 1770

J. G. McGEHEE

FORM 275 FOR SALE BY KANSAS BLUE PRINT CO.


County Graham State Kansas

Sec. 14 (Blk. Twp.) 10 (Sur. Rge.) 21W Map No.

Operator Jones, Shelburne & Farmer

Well No. 5 Farm Acheson

Elev. 2192 Location C W L SW NE

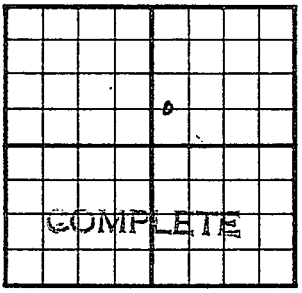

660 Ft. From S Line NE

330 Ft. From W Line Quarter

1st. Report

Completion FEB 3 1954

Remarks

Spudding Date 12-14-53

Drlg. Data Oil well TD 3742

8" @ 185 Anhy 1651 Heeb. 3396

Tor. 3427 Lans. 3443 B KC 3663

Simp. 3721 Arb. 3732 TD 3740

5" @ 3734 DD 3742 S/ 1½ boph 4 hr.

1000 A S/ 12 boph 12 hr.

Comp. 265 bopd

R G. McGEHEE