



DX 78-1

Section 14 Township 10 Range 21W
Well No. 6 Acheson
Company Skelly Oil

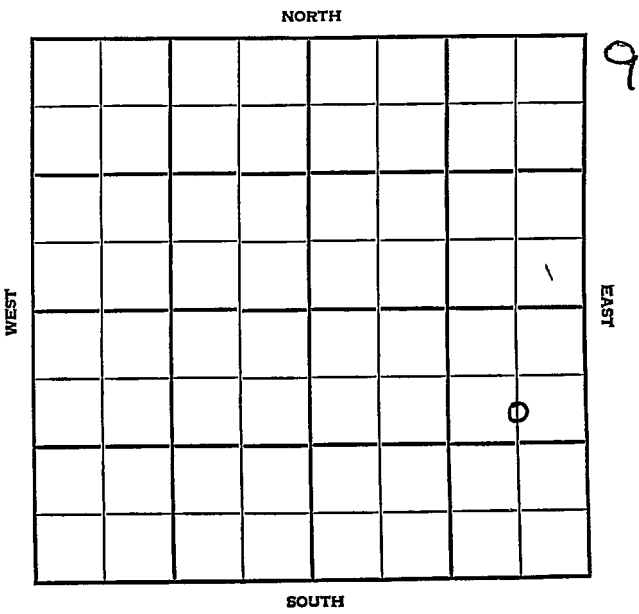

SEC.	TWP.	R.
14	10	21W
WELL NO.		
6 Acheson		FARM
COMPANY		
Skelly Oil		
CONTRACTOR		


_____ Ft. from W. Line

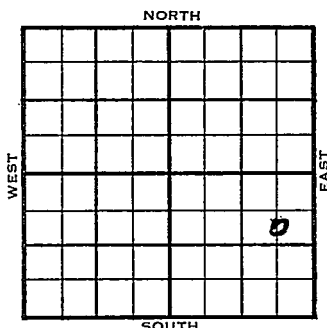

C S $\frac{1}{2}$ NE SE

	ELEVATION	REPORT
1954	2220'	
7/21	Location	
8/25	Spud 7-24-54	
	D&A	
	TD 3811'	
	8" @ 318'	
	Heeb 3441', Tor 3466', Lans 3481'	
	DST 3474-92', opn $\frac{1}{2}$ hrs., rec. 10' mud,	
	70#	
	DST 3647-58', opn $\frac{1}{2}$ hrs., rec. 5' mud,	
	0#	
	Cong 3779', Arb. 3782'	
	DST 3777-86', opn 1/2 hrs., rec. 15'	
	ocm, 640#	
	TD 3786'	
	5" @ 3783'	
	CO to 3786	
	12/3779-82, 250 A	
	2 go 4 gwph	
	DD 3794, 500A	
	Sd-oil-frac, B/5 go 15 gw 4 hrs.	
	DD 3811 hole caving	
	D&A	

ABANDONED

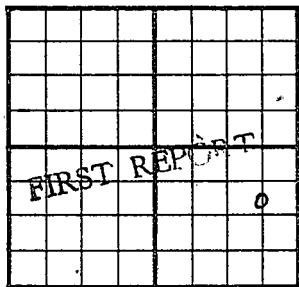County Graham State KansasSec. 14 (Blk. Twp.) 10 (Sur. Rge.) 21W Map No.Operator Skelly OilWell No. 6 Farm AchesonElev. Location C S $\frac{1}{2}$ NE SE990 Ft. From N Line SE660 Ft. From E Line Quarter1st. Report JUL 21 1954

Completion


Remarks

Spudding Date

Drilg. Data

Location

J. G. McGEHEE

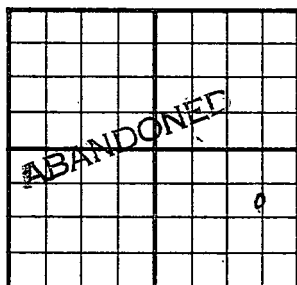County Graham State KansasSec. 14 (Blk.) 10 (Sur. Rge.) 21W Map No.Operator Skelly OilWell No. 6 Farm AchesonElev. 2220 Location C S $\frac{1}{2}$ NE SE990 Ft. From N Line SE660 Ft. From E Line Quarter

1st. Report

Completion AUG 25 1954

Remarks

Spudding Date 7-24-54Drig. Data D & A TD 38118" @ 318 Heeb. 3441 Tor. 3466Lans. 3481 DST 3474-92 open $\frac{1}{2}$ hr.Rec. 10' mud 70# DST 3647-58open $\frac{1}{2}$ hr. Rec. 5' mud 0# Cong. 3779Arb. 3782 DST 3777-86 opne $\frac{1}{2}$ hr.Rec. 15' ocm 640# TD 3786 5" @ 3783CO to 3786 12/ 3779-82 250 A2 go 4 gwph DD 3794 500 Asd-oil-frac B/ 5 go 15 gw 4 hr.DD 3811 hole cavingD & A

FABEN GILSTRAP