


Section 14 Township 10 Range 21-W

Well No. #1 Driscoll

Company Peel & Hardman

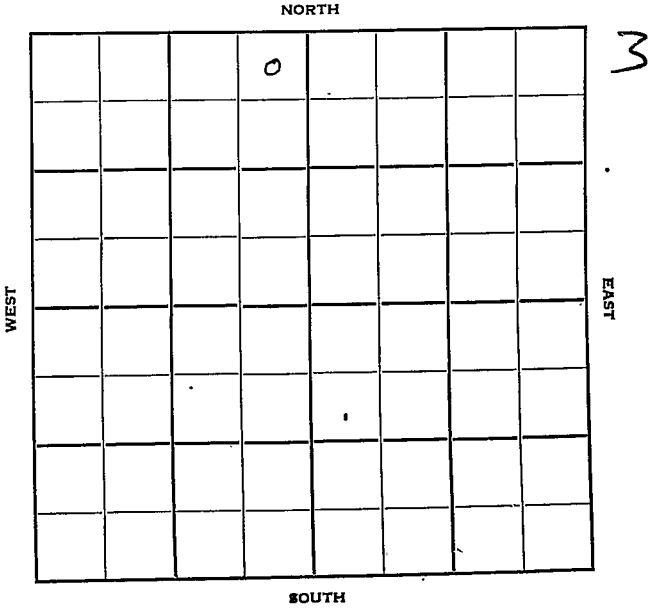

Sec. 14 Twp. 10 R. 21-W ✓

Well No. #1 Driscoll Farm

Peel & Hardman Company

Peel Drlg. Contractor


Wildcat  
330 Ft. from N. Line

\_\_\_\_\_ Ft. from S. Line

330 Ft. from E. Line

\_\_\_\_\_ Ft. from W. Line

NE NE NW

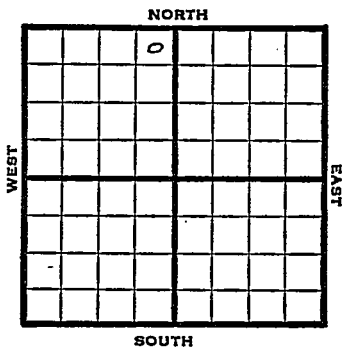

1950 Elev. 2228! REPORT

10/18 Cellar & Pits

11/8 Spud 10-30-50  
 D&A TD 3862'  
 8-5/8" @ 154' Top 3245'  
 Heeb 3457' Lans. 3496'  
 SSO 3580-3600 Cong. 3785'  
 Arb. 3822'  
 DST 3824-62 TD opn 40 min.  
 Rec. 35' watery mud.  
 D&A

**ABANDONED**

County Graham State Kansas

Sec. 14 (Blk. 10) (Sur. 21W) (Twp.) (Rge.) Map No.

Operator Peel & Hardman

Well No. 1 Farm Driscoll

Elev. Location NE NE NW

		0			

330 Ft. From N Line NW

330 Ft. From E Line Quarter

1st. Report OCT 18 1950

Completion

Remarks

Peel Drlg. - Contr.

Spudding Date

Drlg. Data Wildcat

Cellar & pits

J. E. TYRA

