

KANSAS DRILLERS LOG

API No. 15 — 141 — 20055
County Number

Operator
Messman-Rinehart Corp.

Address
1432 Vickers KSB&T Bldg.; Wichita, Ks. 67202

Well No. #1 Lease Name Meyers "A"

Footage Location
710 feet from ~~XXX~~ (S) line 660 feet from ~~XXX~~ (W) line SE/4

Principal Contractor Dreiling Oil, Inc. Geologist George Klein

Spud Date October 25, 1978 Total Depth 3710' P.B.T.D.


Date Completed November 2, 1978 Oil Purchaser None

S. 7 T. 10S R. 14W W

Loc. 50' N of C SW SE

County Osborne

640 Acres
N

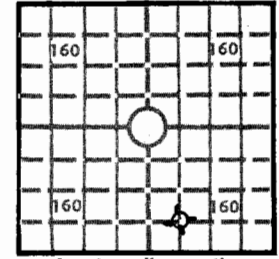

Locate well correctly

Elev.: Gr. 1937'

DF _____ KB 1942'

CASING RECORD

Report of all strings set — surface, intermediate, production, etc.

Purpose of string	Size hole drilled	Size casing set (in O.D.)	Weight lbs/ft.	Setting depth	Type cement	Sacks	Type and percent additives
Surface	12 1/4	8 5/8	20#	293'	Common	180	2% Gel 3% Cal. Chloride

LINER RECORD

PERFORATION RECORD

Top, ft.	Bottom, ft.	Sacks cement	Shots per ft.	Size & type	Depth interval

TUBING RECORD

Size	Setting depth	Packer set at

ACID, FRACTURE, SHOT, CEMENT SQUEEZE RECORD

Amount and kind of material used	Depth interval treated

INITIAL PRODUCTION

Date of first production <u>None</u>	Producing method (flowing, pumping, gas lift, etc.) <u>Dry Hole</u>
RATE OF PRODUCTION PER 24 HOURS	Oil <u> </u> bbls. Gas <u> </u> MCF Water <u> </u> bbls. Gas-oil ratio <u> </u> CFPB
Disposition of gas (vented, used on lease or sold)	Producing interval (s)

INSTRUCTIONS: As provided in KCC Rule 82-2-125, within 90 days after completion of a well, one completed copy of this Drillers Log shall be transmitted to the State Geological Survey of Kansas, 4150 Monroe Street, Wichita, Kansas 67209. Copies of this form are available from the Conservation Division, State Corporation Commission, 3830 So. Meridian (P.O. Box 17027), Wichita, Kansas 66217. Phone AC 316-522-2206. If confidential custody is desired, please note Rule 82-2-125. Drillers Logs will be on an open file in the Oil and Gas Division, State Geological Survey of Kansas, Lawrence, Kansas 66044.

Operator Messman-Rinehart Corporation		DESIGNATE TYPE OF COMP.: OIL, GAS, DRY HOLE, SWDW, ETC.:
Well No. #1	Lease Name Meyers "A"	Dry Hole
S <u>7</u> T <u>10S</u> R <u>14</u> ^K / _W		


WELL LOG

Show all important zones of porosity and contents thereof; cored intervals, and all drill-stem tests, including depth interval tested, cushion used, time tool open, flowing and shut-in pressures, and recoveries.

SHOW GEOLOGICAL MARKERS, LOGS RUN, OR OTHER DESCRIPTIVE INFORMATION.

FORMATION DESCRIPTION, CONTENTS, ETC.	TOP	BOTTOM	NAME	DEPTH
NO ELECTRIC LOG RUN				
DST #1 - 2654-2745' Tool open 15 min., SI 20 min. open 30 min., SI 30 min. Weak blow dead 12 min. into second opening. Rec. 40' rotary mud. IBHP 876#, IFP 74#, FFP 74#, FBHP 854#, Temp. 88°.			Anhydrite	1189 (+ 753)
			U.Tarkio Sd.	2652 (- 710)
			Tarkio Lm.	2741 (- 799)
			Topeka	2896 (- 954)
			Queen Hill	3072 (-1130)
DST #2 - 3206-3240' Tool open 30 min., SI 20 min. Open 30 min., SI 30 min. Weak blow dead on second opening. Recover 60' rotary mud. IBHP 654#, IFP 63#, FFP 63#, FBHP 886#, Temp 98°.			Heebner	3146 (-1204)
			Toronto	3168 (-1226)
			Lansing	3198 (-1256)
			Cong.	3599 (-1657)
			Cherty Cong.	3646 (-1704)
			Viola	3702 (-1760)

USE ADDITIONAL SHEETS, IF NECESSARY, TO COMPLETE WELL RECORD.

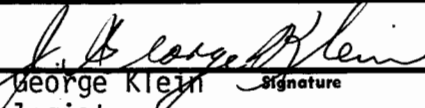Date Received	
	J. George Klein Geologist
	Title
	February 8, 1979
	Date

EL-02L