
FORM 51 25M 8-50 WESTERN Sheridan KANSAS

Section 15 Township 10 Range 28W

Well No. #1 Bicker

Company Armer-Koplin

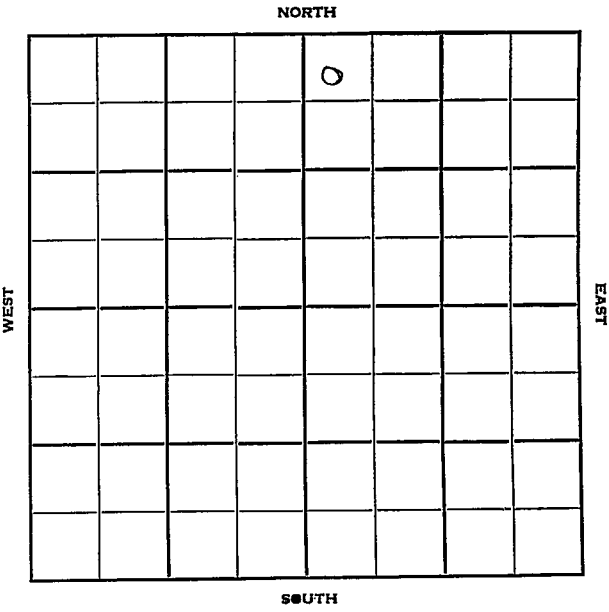

FORM 252-B
10M 8-51 TPCO.

Sheridan KANSAS

Sec. 15 Twp. 10 R. 28W

Well No. #1 Bicker Farm

Armer-Koplin Company

Contractor

Wildcat


330' Ft. from N. Line

Ft. from S. Line

Ft. from E. Line

330' Ft. from W. Line

NW NW NE

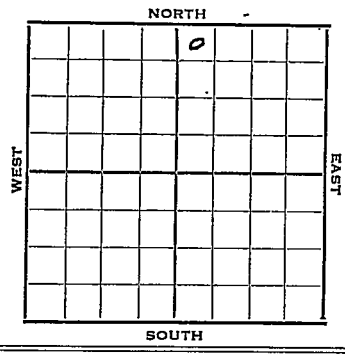

1951	Elev. 2742' REPORT
12/12	Cellar & Pits
1952	
1/2	Spud 12-10-51 D&A TD 4695 8" @ 160' Anhy 2270 Heeb. 3821 Lans. 3869 Miss. 4437 DST 3988-4088 rec. 30' mud Arb. 4629-95 TD D&A

ABANDONED

FORM 275 FOR SALE BY KANSAS BLUE PRINT CO.


County Sheridan State Kansas

Sec. 15 (Blk. Twp.) 10 (Sur. Rge.) 28W Map No.

Operator Armer - Koplin

Well No. 1 Farm Bicker

Elev. Location NW NW NE

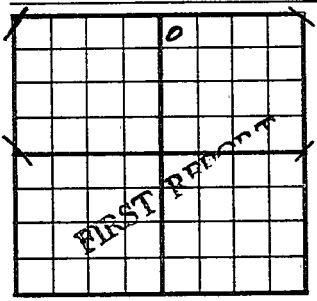

330 Ft. From N Line NE

330 Ft. From W Line Quarter

1st. Report DEC 1 2 1951

Completion

Remarks Shell - DHM

Spudding Date

Drlg. Data Wildcat

Cellar & pits

J. E. TYRA

FORM 275 FOR SALE BY KANSAS BLUE PRINT CO.


County Sheridan State Kansas

Sec. 15- (Blk. Twp.) 10 (Sur. Rge.) 28W Map No.

Operator Armer & Coplin

Well No. 1 Farm Bicker

Elev. 2742 Location NW NW NE

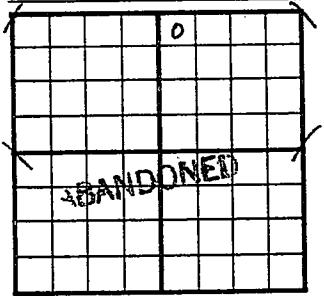

330 Ft. From N Line NE

330 Ft. From W Line Quarter

1st. Report

Completion JAN 2 1952

Remarks Wildcat
Prime Drlg. - Contr.

Spudding Date 12-10-51

Drlg. Data D & A TD 4695

8" @ 160 Anhy 2270 Heeb. 3821

Lans. 3869 Miss. 4437 DST 3988-4088

Rec. 30' mud Arb. 4629-95 TD

D & A

J. E. TYRA