
Graham

KANSAS

SECTION 15 TOWNSHIP 10S RANGE 25W

WELL NO. #3 Pfeifer "A"

COMPANY Herndon Drlg.

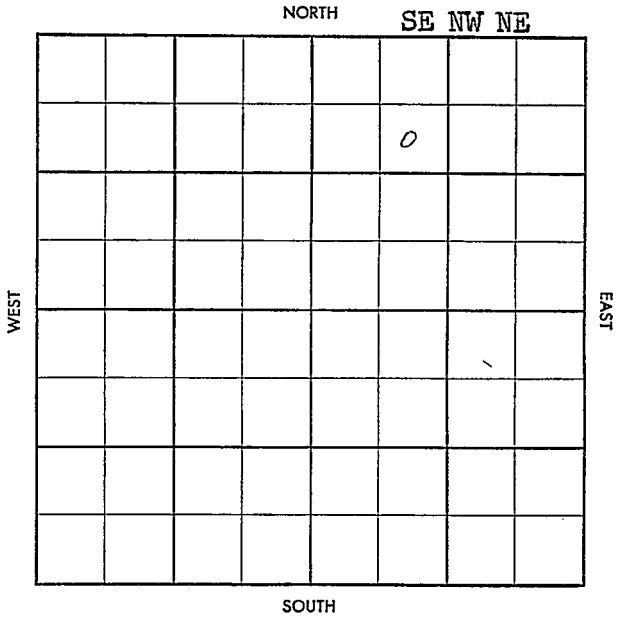

FORM 504-3 SUNRAY

Twp. Pool

Co. Facet

S-513-B

County Graham Elev.

Sec. 15 Twp. 10 Rge. 25W

Company Herndon Drlg.

Farm Name Pfeifer "A" No. 3

TOPS	DEPTH	LOG	DATUM
Anh.			
Tp.			
H.			
Tr.			
Dg.			
B. L.			
L.			
K.C.			
B.K.C.			
Ce.			
C.			
M.			
M.			
K.			
Mz.			
Mq.			
V.			
S.			
S.			
A.			
R.			
Pf.			
G.			
T.D.			

Loc. in Sec. SE NW NE

Geol.

Contr. Co. Tools

Pool Elrick NE


FIRST REPORT

JUN 25 '58

Date Comm.

WORT

Co. Lse. No. Sec. T. R.

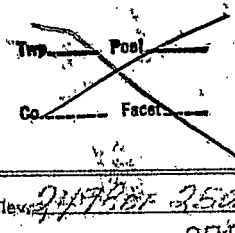

S 13 B 1

County Graham Elev. 2472Df 2525KB

Sec. 15 Twp. 10 Rge. 25W

Company Herndon Drlg.

Farm Name Pfeifer "A" No. 3

TOPS	DEPTH	LOG	DATUM
Anh.			
Tp.			
H.		3728	
T.		3748	
Dg.			
B.L.	3760	3760	
L.			
K.C.			
B.K.C.			
Ce.			
C.			
M.			
M.			
K.			
Mz.			
Mq.			
V.			
S.			
A.			
R.			
Pf.			
G.			
T.D.	4025		

Loc. in Sec. SE NW NE

Geol.

Contr. Co. Tools

Pool Elrick NE

COMPLETE SEP 17 '58

Date Comm. 7-1-58 8" 219/58

W.O.T. JUL 2 '58 MIR JUL 9 '58 Ø 3500

JUL 16 '58 DST 3786-3802 1hr

3000 on NW BHP 1295 JUL 28 '58

55 4024 WOCT JUL 30 '58

AUG 6 '58 AUG 13 '58

AUG 20 '58 MI AUG 27 '58 Co 4000 24/3984

90 A $ 580 ph NW 24/3963-69

24/3941-49 PEr 3975 A Chemlog

PB 3915 16/3900-04 8/3907-09

A + 24 Bbph NW NT Pop SEP. 3 '58

SEP. 10 '58 SEP 17 '58 Phy P 132 Bopd NW 43°gr

Lse. No. Sec. T. R.