


Section 15 Township 10 S Range 25 WWell No. #1 DinkelCompany Empire Drlg. & N.C.R.A.

NORTH

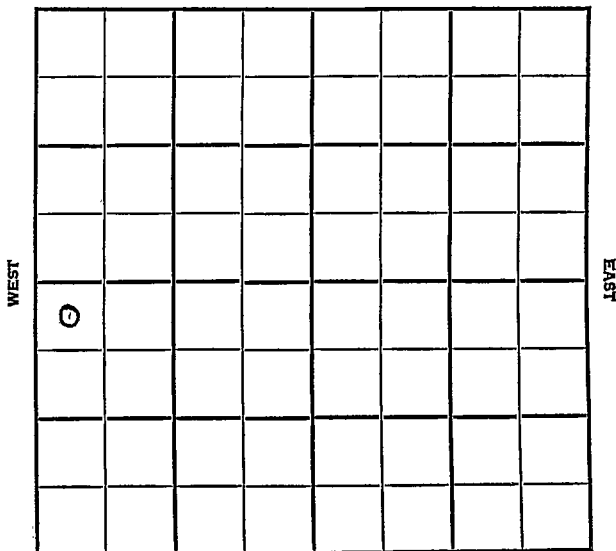

SOUTH

Graham

KANSAS

SEC.	15	TWP.	10S	R.	25W
------	----	------	-----	----	-----

WELL NO.

#1 Dinkel

FARM

COMPANY

Empire Drlg & NCRA

CONTRACTOR

Empire Drlg


Rank WC

_____ Ft. from N. Line

_____ Ft. from S. Line

_____ Ft. from E. Line

_____ Ft. from W. Line

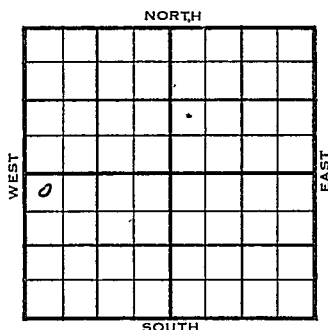

NW NW SW

1955

ELEVATION

2476 RB

REPORT

9/28

Comm 9/20/55
 8" @ 169 w/115
 D 3365
 Anh 2095

11-16

DST 3740-95 op 1 hr. gas in 45 min, rec 735' hocm, 330' mco, 1560' clean oil, 1340#

DST 3788-3815 op 1 hr. gas in 28 min. rec 2015' gassy oil, 180' ocm, 1300/20"

DST 3814-35 op 1 hr. rec. 215' hocm 25' oil 5' wtr., 1250/30"

DST 3835-70 op 1/2 hr. rec. 10' mud ### 200/30"

DST 3874-98 op 1 hr. gas in 18 min. rec. 350' gassy oil, 240' mco, 75' vhocm 760/30"

DST 3898-3918 op 1 hr. rec. 20' mud 0#

DST 3912-42 op 1 1/2 hr. rec 365' GIP 115' ocm, 740/30"

DST 3936-60 op 1 hr., 900' GIP, rec 230' hocm, 540' clean oil, 420' wtr., 1260/30"

DST 4190-4205 op 45 min. rec 10' mud 110#

5 1/2" @ 3975/125

CO 8/ 3950-52, S/ 19 go , 26 gw 45 min.

PB 3940, 20/ 3931-36, S/ 30 goph

3000 A, S/ 50 boph, S/ 45 boph

Comp. 389 bopd.

DX-78

OVER

11-16	TOPS	DEPTH
	H. ##	3712
	Tr.	3736
	L.	3757
	B.K.C.	3980
	Ce.	4188
	T.D. 4205'	

COMPLETED

County Graham Elev. 2476 RBSec. 15 Twp. 10S Rge. 25WCompany Empire Drlg & N.C.R.A.Farm Name Dinkel No. 1

TOPS

DEPTH

LOG

DATUM

Anh.

2095

Loc. in Sec.

Tp.

NW NW SE

H.

Tr.

Dg.

BL.

L.

K.C.

Geol. Gene Taylor

B.K.C.

Contr.

Ce.

Empire Drlg

C.

M.

Pool

M.

K.

Rank WC

Mz.

Ma.

V.

S.

S.

A.

FIRST REPORT

R.

P.E.

G.


T.D.

Date Comm. 9-20-55

SEP 28 1955

8" 169 W/115; D 3365

200/30" DST 3874-98 open 1 hr.
 gas in 18 min. rec. 350' gassy oil
 240' mco 75' vhoem 760/30"
 DST 3898-3918 open 1 hr. rec. 20' mud
 O# DST 3912-42 open 1 $\frac{1}{2}$ hr. rec.
 365' GIP - 115' ocm 740/30"
 DST 3936-60 open 1 hr. 900' GIP
 Rec. 230' hoem. 540' clean oil 120' wtr.
 1260/30" DST 4190-4205 open 45 min.
 rec. 10' mud 110# 5 $\frac{1}{2}$ " @ 3975/125
 CO 8/ 3950-52 S/ 19 go 226 gw 45 min.
 PB 3940 20/ 3931-36 S/ 30 goph.
 3000 A S/ 50 boph S/ 45 boph
 Comp. 389 bopd

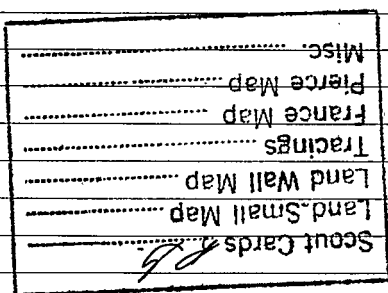

NOV 25 1955

County Graham

Elev.

2173 DF

2476 RB


Sec. 15 Twp. 10

Rge.

25W

Company Empire Drlg. & NCRAFarm Name DinkelNo. 1

TOPS	DEPTH	LOG	DATUM	Loc. in Sec.
Anh.	2095			NW NW SW
TP.				
H.	3712		1236	
Tr.	3736		1268	
Dg.				
BL.				
L.	3757		1281	Geol.
K.C.				
B.K.C.	3980		1574	Contr.
Ce.	4188		1712	Empire Drlg.
C.				
M.				Pool
M.				
K.				
Mz.				
Mq.				
V.				
S.				
S.				
A.				
R.				
PE.				
G.				
TD.	4205			

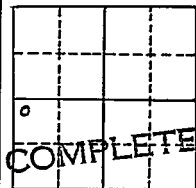Date Comm. 9-20-55

NOV 16 1955

8" @ 169/115 DST 3740-95 open 1 hr.

gas in 45 min. rec. 735' hocm 330' meo

1560' clean oil 1340# DST 3788-3815

open 1 hr. gas in 28 min. rec.

2015' gassy oil 180' ocm 1300/20"

DST 3814-35 open 1 hr. rec. 215'

hocm 25' oil 5' wtr. 1250/30"

DST 3835-70 open 1 hr. rec. 10' mud