


Graham KANSAS

SECTION 15 TOWNSHIP 10 S RANGE 25 W

WELL NO. # 2 Schreiner "B"

COMPANY Empire Drlg. & NCRA

NORTH NE NW NW

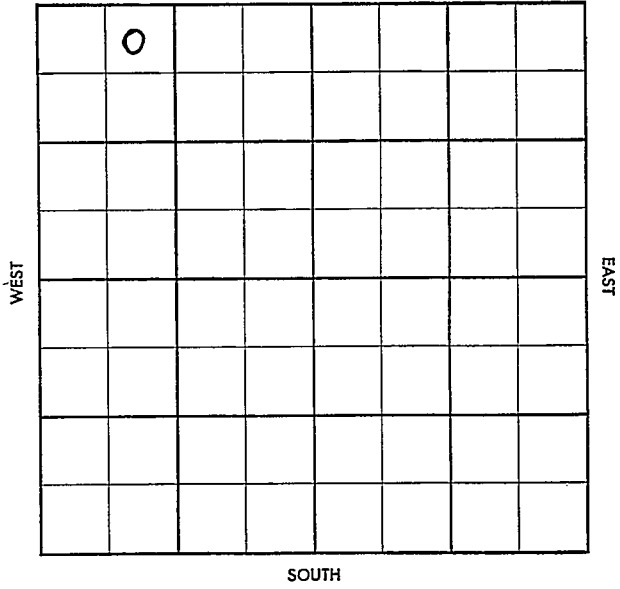

~~THE~~ ~~PEOL~~
~~CL~~ ~~CL~~

S-513-B

County Graham Elev. _____
 Sec. 15 Twp. 10 Rge. 25W
 Company Empire Drlg. & N.C.R.A.
 Farm Name Schreiner "B" No. 2

TOPS	DEPTH	LOG	DATUM
Anh.			
Tp.			
H.			
Tr.			
Dg.			
B.L.			
L.			
K.C.			
B.K.C.			
Ce.			
C.			
M.			
M.			
K.			
Mz.			
Mq.			
V.			
S.			
S.			
A.			
R.			
Pf.			
G.			
T.D.			

Loc. in Sec. _____
NE NW NW
 Geol. _____
 Contr. _____
 Co. Tools _____
 Pool _____
Elrick NE

JUL 23 58
FIRST REPORT

Date Comm. 7-21-58
8" @ 150 w/100 Drlg. 600

Co. _____
 Lse. _____
 No. _____
 Sec. _____
 T. _____
 R. _____

Twp. C Pool C

Co. C Facet C

S-513-B

County Graham Elev. 2509 or 2512

Sec. 15 Twp. 10 Rge. 25W

Company Empire Drilg. & A.C. Inc.

Farm Name Schreiner "B" No. 2

TOPS	DEPTH	LOG	DATUM
Anh.	<u>2135</u>		
Tp.			
H.	<u>3742</u>		
Tr.	<u>3764</u>		
Dg.			
B.L.			
L.	<u>3781</u>		
K.C.			
B.K.C.			
Ce.			
C.			
M.			
M.			
K.			
Mz.			
Mq.			
V.			
S.			
S.			
A.			
R.			
Pf.			
G.			
T.D.	<u>3995</u>		

Loc. in Sec. _____
 M. E. N.
 Geol. _____
 Contr. _____
 Co. Tools _____
 Pool _____
 Erick I.E.

COMPLETE
 AUG 27 '58

Date Comm. 7-21-58

8" 150 w/100 Drls. 600 JUL 30 '58 DST 3748
-70 1/2 hr 4' M BHP 820/30"
DST 3774 -3800 1/2 hr 7' M
FPD BHP 1120/30" DST 3804 -20
4.5" 30' M SLCU oil BHP 180/30"
DST 3850 -65 1 hr 1230' gip
25' OCM + 115' H DCM 5' W
BHP 1260/30" #3877 AUG 6 '58 DST
3903 -20 30" 20' M SPK oil

Co.
 Twp.
 Rge.
 Sec.
 No.
 T.
 R.

at P O DST 3925'-60" 60"

665' JWP 115.08 gen BHP

980 5 1/2 3994/45 AUG 13 '58

16/3972-78 rainbow (3)

6.5.2 BOPh. NW 7hrs POP

AUG 20 '58 AUG 27 '58 Phy P 115 BOPh NW

LSG 3972-78

15-10-25W ne ne ne