

Section 15 Township 10 Range 14W

Well No. #1 Meyer

Company Cox & Cox

NORTH

0							

4

WEST

EAST

SOUTH

Sec. 15 Twp. 10 R. 14W

Well No. #1 Meyer Farm

Cox & Cox Company

Helton - Contr. Contractor


330' Ft. from N. Line

_____ Ft. from S. Line

_____ Ft. from E. Line

330' Ft. from W. Line

NW NW NW

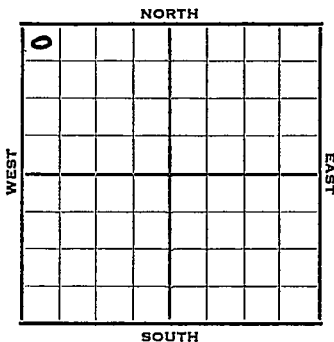

1952

Elev. 2012 REPORT

8/27

Spud 8-21-52
8" @ 153

9/3

Anhy 1145 Heeb. 3170
Tor. 3192 Lans. 3218
DST 3216-36, 1 hr. 5'm

9/10

DST 3242-65
Spud 8-21-52
D&A TD 3910
8" @ 153 Anhy 1145 Heeb. 3170
Tor. 3192 Lans. 3218
DST 3216-36 opn 1 hr. Rec. 5' mud
DST 3242-65 opn 1 hr. Rec. 15' mud
250# Cong 3617 Viola 3747
Simp. 3828 Arb. 3879 TD 3910
D&A

ABANDONED

County Osborne State Kansas

Sec. 15 (Blk. Twp.) 10 (Sur. Rge.) 14W Map No.

Operator Cox & Cox

Well No. 1 Farm Meyer

Elev. _____ Location NW NW NW

0					

FIRST REPORT

330 Ft. From N Line NW

330 Ft. From W Line Quarter

1st. Report AUG 27 1952

Completion _____

Remarks _____

Helton - Contr.

Spudding Date 8-21-52

Drig. Data _____

8" @ 153

J. G. McGEHEE

County Osborne State Kansas

Sec. 15 (Bk. 10) (Sur. 14W) (Rge.) Map No.

Operator Cox & Cox

Well No. 1 Farm Meyer

Elev. 2012 Location NW NW NW

o							

330Ft. From N Line NW

330Ft. From W Line Quarter

1st. Report

Completion SEP 10 1952

Remarks

Hilton Drlg. - Contr.

Spudding Date 8-21-52

Drlg. Data D & A TD 3910

8" @ 153 Anhy 1145 Heeb. 3170

Tor. 3192 Lans. 3218 DST 3216-36

open 1 hr. Rec. 5' mud DST 3242-65

open 1 hr. Rec. 15' mud 250#

Cong. 3617 Viola 3747 Simp. 3828

Arb. 3879 TD 3910

D & A