


Section 15 Township 10 Range 19W

Well No. 1 Adolph Nutsch

Company Skelly Oil

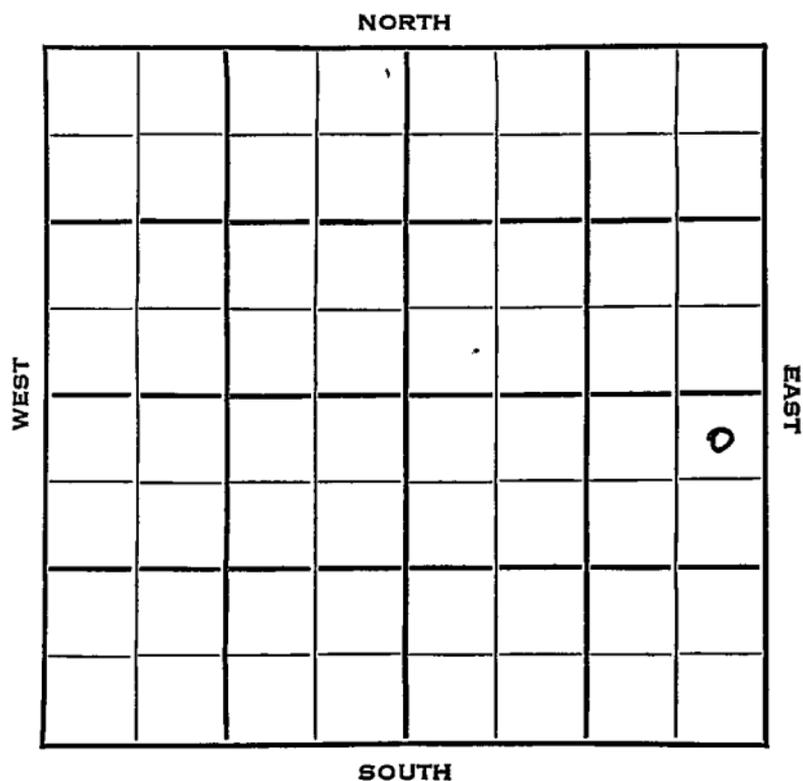






County \_\_\_\_\_ Rooks \_\_\_\_\_ State Kansas

Sec. 15 (Blk. (Twp.)) 10 (Sur. Rge.) 19W Map No. \_\_\_\_\_

Operator Skelly Oil

Well No. 1 Farm Adolph Nutsch

Elev. 2170 Location NE NE SE

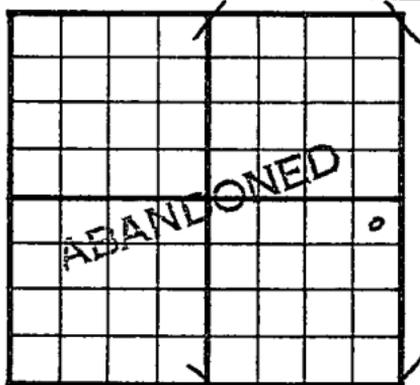

330 Ft. From N Line SE

330 Ft. From E Line Quarter

1st. Report

Completion FEB 3 1954

Remarks Wildcat

Wentworth - Contr.

Spudding Date 1-10-54

Drig. Data D & A TD 3804

8" @ 278 Top. 3152 Heeb. 3370

Tor. 3395 Lans. 3409 DST 3556-3612

open 45 min. Rec. 180' mud 775#

Cong. 3661 EroArb. 3787 Arb. 3798

TD 3804

D & A