

KANSAS

Rooks

Section 15 Township 10 Range 20W

Well No. 4 Brugemann

Company Champlin Ref.

Marcotte
NORTH

			6				

WEST

EAST

SOUTH

Rocks

KANSAS

Sec. 15 Twp. 10 R. 20N

Well No. #4 Brugemann Farm

Champlin Ref.

Company

Marcotte (Champlin Refg, Cont.)


Pool

990' Ft. from N. Line

_____ Ft. from S. Line

330' Ft. from E. Line

_____ Ft. from W. Line

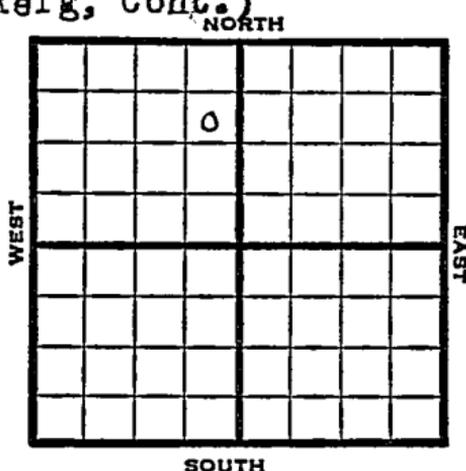

SE NE NW

1949

Elev. 2209 DF REPORT

9/7 Location

9/14 RUR

9/21 8" @ 181'

Drlg. 3040'

9/28 Lansing 3466'

Arbuckle 3753-60'

TD 3760'

5" @ 3754'

10/5 2500' oil 1 hr

10/12 Swb 50 bbls oil PH

10/19 "

10/26 "

11/1 "

11/9 "

11/16 TD 3760'

Arb. 3757'

5" @ 3754'

Echo Pot 1440 oil / 40% W Pot

27³ Gr.

Comp

COMPLETED

Map No. _____ Sec. 15 Twp. 10 R. 20W

Well No. 4 Brugemann

Champlin Ref. _____ Company

Champlin Ref. _____ Contractor

SE NE NW

FIRST REPORT
SECTION PLAT

990 Ft. from N. Line

_____ Ft. from S. Line

330 Ft. from E. Line

_____ Ft. from W. Line

Rocks County

RECORD

Location X

Rig up _____

Drilling and Remarks:

Cased _____ in., _____ ft.

Sand _____

Gas _____

Oil _____

Total Depth _____

PRODUCTION

1st 24 hrs. Nat. _____

1st 24 hrs. after shot _____

Gas _____ Cu. Ft.

Dry Hole _____

Abandoned _____

Date

SEP 7 1940 19

S. J. LEWIS

Scout

Map No. _____ Sec. 15 Twp. 10 R. 20W

Well No. 4 Brugemann

Champlin Ref. _____ Company

COMPLETE _____ Contractor

SE NE NW

E. 2209
SECTION PLAT

990 Ft. from N. Line

_____ Ft. from S. Line

330 Ft. from E. Line

_____ Ft. from W. Line

Rooks County

Location _____

Rig up _____

Drilling and Remarks:

Art 8757

5" 8257

Echo B 14400d

+ 40' N P 27

27 3/4

RECORD

Cased _____ in., _____ ft.

Sand _____

Gas _____

Oil _____

Total Depth *3260*

PRODUCTION

1st 24 hrs. Nat. _____

1st 24 hrs. after shot. _____

Gas _____ Cu. Ft.

Dry Hole _____

Abandoned _____

Date

NOV 16 1949 19

S. J. LEWIS Scout