

KANSAS


FORM 51 5M PETROL

Rooks

Section 15 Township 10 Range 20-W


Well No. #1 Marcott

Company Champlin Ref.

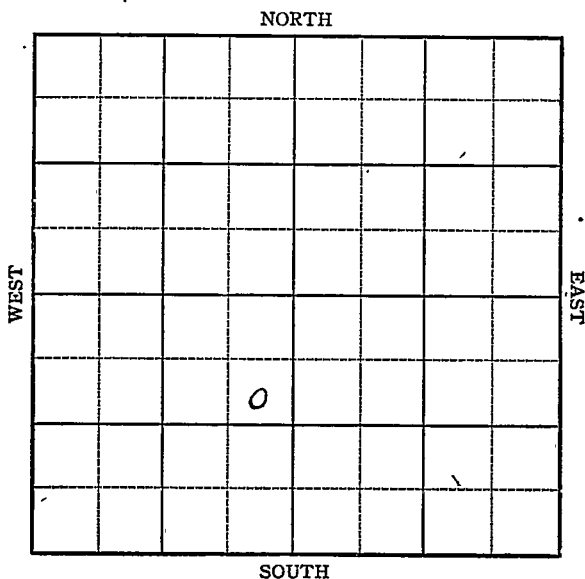

KANSAS

Rooks

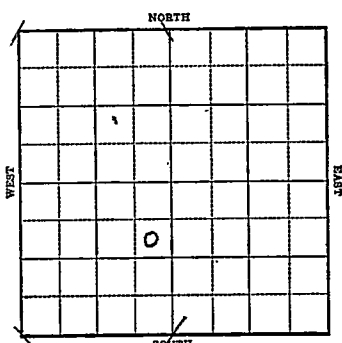Sec. 15 Twp. 10 R. 20-WWell No. #1 Marcott FarmChamplin Ref. Company990 Ft. from N. Line Ft. from S. Line330 Ft. from E. Line Ft. from W. LineElev. 2204

1943

R E P O R T

11/3 Material

11/10 "

11/17 "

11/24 "

12/1 10" @ 130 WOC

12/8 No report

12-15 Drlg. 3736'

12/22 Lans 3464

Cong 3738

Simp 3743

Arb 3753

TD 3764-1380 of heavy black oil

Run csg.

12/29 5" @ 3763 30 shots 3752-58
250 acid so & 50 oil in 1 hr
29° gravity

1944

1-5 " " "

1-12 " " "

1/19 " " "

1/26 " " "

2/2 " "

OVER

1944

2/9

5" @ 3763

Arb 3753

TD 3764

30 shots 3752-58

250 acid

Depth Pot 2811

Gravity 29

COMPLETED

KANSAS

Map No. 65 Sec. 15 Twp. 10 R. 20WWell No. 1 Marcott


Champlin Ref. _____ Company _____

FIRST REPORT

Contractor _____

SE NE SW

SECTION PLAT

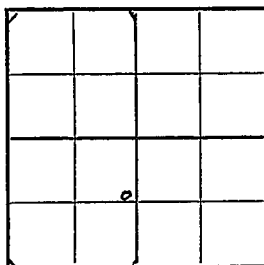990 Ft. from N. Line

_____ Ft. from S. Line

330 Ft. from E. Line

_____ Ft. from W. Line

Wildcat

RECORD

Location _____

Cased _____ in., _____ ft.

Rig up _____

Sand _____

Drilling and Remarks:

Gas _____

Oil _____

Material _____

Total Depth _____

PRODUCTION

1st 24 hrs. Nat. _____

1st 24 hrs. after shot _____

Gas _____ Cu. Ft.

Dry Hole _____

Abandoned _____

Date

NOV 3 1943 19

S. J. LEWIS Scout

KANSAS

Map No. 61 Sec. 15 Twp. 10 R. 20WWell No. 1 Marcott

Champlin Ref.

Company

COMPLETED

Contractor

SE NE SW


SECTION PLAT

990 Ft. from N. Line

Ft. from S. Line

330 Ft. from E. Line

Ft. from W. Line

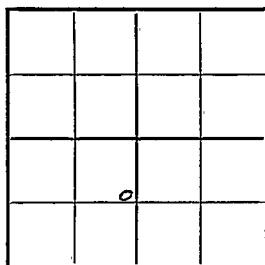

Wildcat

Location

Rig up

Drilling and Remarks:


RECORD

Cased _____ in., _____ ft.

Sand _____

Gas _____

Oil _____

Total Depth *3764*

PRODUCTION

1st 24 hrs. Nat. _____

1st 24 hrs. after shot _____

Gas _____ Cu. Ft.

Dry Hole _____

Abandoned _____

Date

FEB 9 1944 19

S. J. LEWIS

Scout