


KANSAS

Section 15 Township 10 Range 20WWell No. 6 MarcotteCompany Champlin Refg.

KANSAS

Rooks

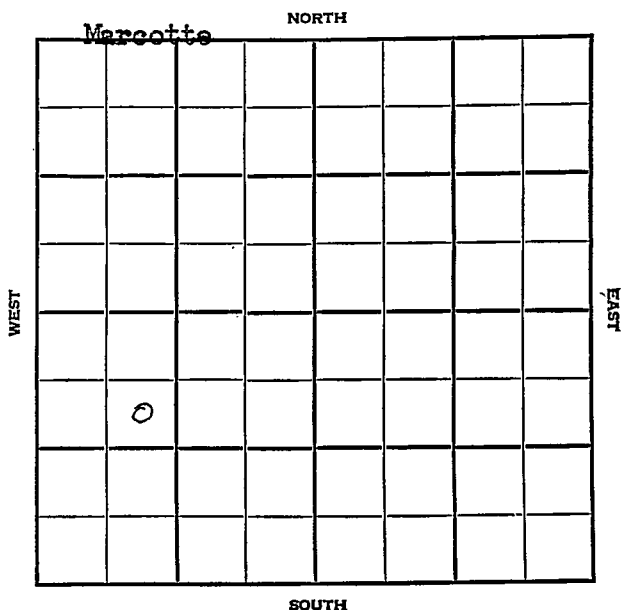

Sec. 15 Twp. 10 R. 20W

Well No. #6 Marcotte Farm
Champlin Ref. Company


Marcotte Pool

990' Ft. from N. Line

Ft. from S. Line

Ft. from E. Line

990' Ft. from W. Line

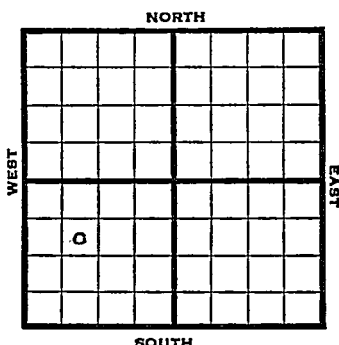

SE NW SW

1948 Elev. 2140' REPORT

3/10 Location

3/17 "

3/24 10" @ 170'
Drlg. 2485'3/31 Lansing 3413'
Soog 3681'
Arbuckle 3717'
Drlg. 3744'4/7 TD 4248'
5" @ 4181'
SWD

4/14 Granite 4248'

4/21 Swb 4 bbls oil & 7 W a day

4/28 "

5/5 "

5/12 "

5/19 Reagan 4218'
Granite 4248'
5" @ 4248'
SWD
TD 4248'

ABANDONED

Map No. _____ Sec. 15 Twp. 10 R. 20W

Well No. 6 Marcotte

Champlin Ref. _____ Company _____

FIRST REPORT _____ Contractor _____

SE NW SW


SECTION PLAT

990 Ft. from N. Line

_____ Ft. from S. Line

_____ Ft. from E. Line

990 Ft. from W. Line

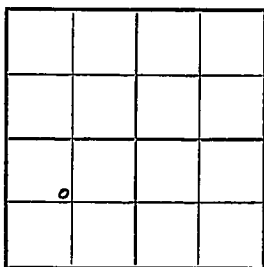

Rooks County

Location X

Rig up _____

Drilling and Remarks:

RECORD

Cased _____ in., _____ ft.

Sand _____

Gas _____

Oil _____

Total Depth _____

PRODUCTION

1st 24 hrs. Nat. _____

1st 24 hrs. after shot _____

Gas _____ Cu. Ft.

Dry Hole _____

Abandoned _____

Date

MAR 10 1948 19 _____ S. J. LEWIS Scout

Map No. 65 Sec. 15 Twp. 10 R. 20
20W

Well No. 6 Marcotte

Champlin Ref.

Company

ABANDONED

Contractor

SE NW SW

E. 1, 2, 40

SECTION PLAT

990 Ft. from N. Line

_____ Ft. from S. Line

_____ Ft. from E. Line

990 Ft. from W. Line

Rooks County

Location _____

Rig up _____

Drilling and Remarks:

Reagan 4218
Grant 4245
5" @ 4245.

BW 11

RECORD

Cased _____ in., _____ ft.

Sand _____

Gas _____

Oil _____

Total Depth 4245

PRODUCTION

1st 24 hrs. Nat. _____

1st 24 hrs. after shot _____

Gas _____ Cu. Ft.

Dry Hole _____

Abandoned _____

Date

MAY 19 1948

19

S. J. LEWIS

Scout