


FORM 51 25M 3-49 PETROL

Section 15 Township 10 Range 20-W

Well No. #8 Marcotte

Company Champlin Ref.

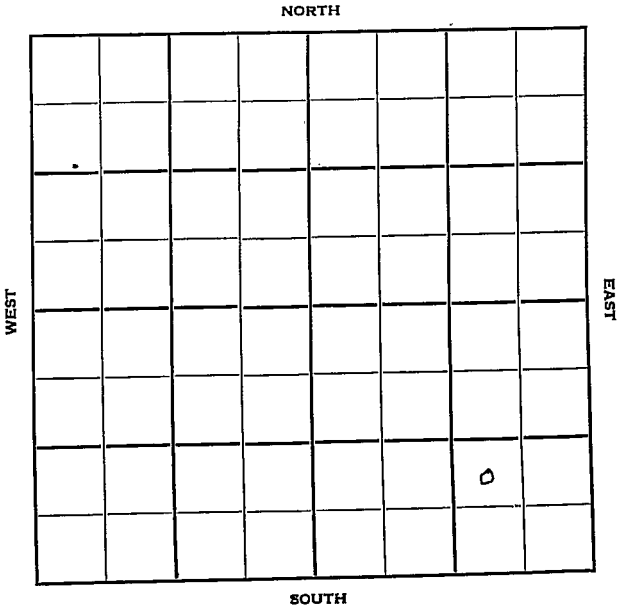

Rooks

10

R. 20W

Sec. 15

Twp.

Well No. #8 Marcotte

Farm

Champlin Refg.

Company

Contractor


Ft. from N. Line

990' Ft. from S. Line

990' Ft. from E. Line

Ft. from W. Line

NW SE SE

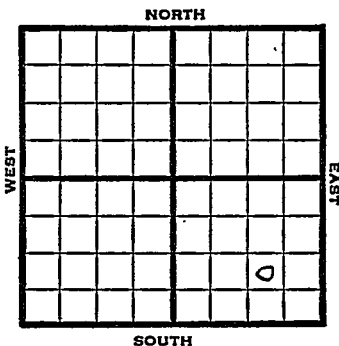

1950

Elev 2197

REPORT

5/24

Rig up

8/2

8 5/8" @ 250

Heeb 3430

Lans 3472

DST 3538-64, opn 10 min rec 7' mud

Arb 3748-51

5" @ 3749 TD 3752

Comp 32 bopd

Completed

**COMPLETED**

Kansas

Map No. \_\_\_\_\_ Sec. 15 Twp. 10 R. 20WWell No. 8 Marcotte

Champlin Ref.

Company \_\_\_\_\_

Contractor \_\_\_\_\_

NW SE SE

## SECTION PLAT

FIRST REPORT			
			o

\_\_\_\_\_ Ft. from N. Line

990 Ft. from S. Line990 Ft. from E. Line

\_\_\_\_\_ Ft. from W. Line

Rocks \_\_\_\_\_

Location \_\_\_\_\_

Rig up X

Drilling and Remarks:

## RECORD

Cased \_\_\_\_\_ in., \_\_\_\_\_ ft.

Sand \_\_\_\_\_

Gas \_\_\_\_\_

Oil \_\_\_\_\_

Total Depth \_\_\_\_\_

## PRODUCTION

1st 24 hrs. Nat. \_\_\_\_\_

1st 24 hrs. after shot \_\_\_\_\_

Gas \_\_\_\_\_ Cu. Ft.

Dry Hole \_\_\_\_\_

Abandoned \_\_\_\_\_

Date

MAY 24 1956J. E. TYRA Scout

