


Section 15 Township 10 Range 22W

Well No. #1 Andreen

Company Jones, Shelborne & Farmer

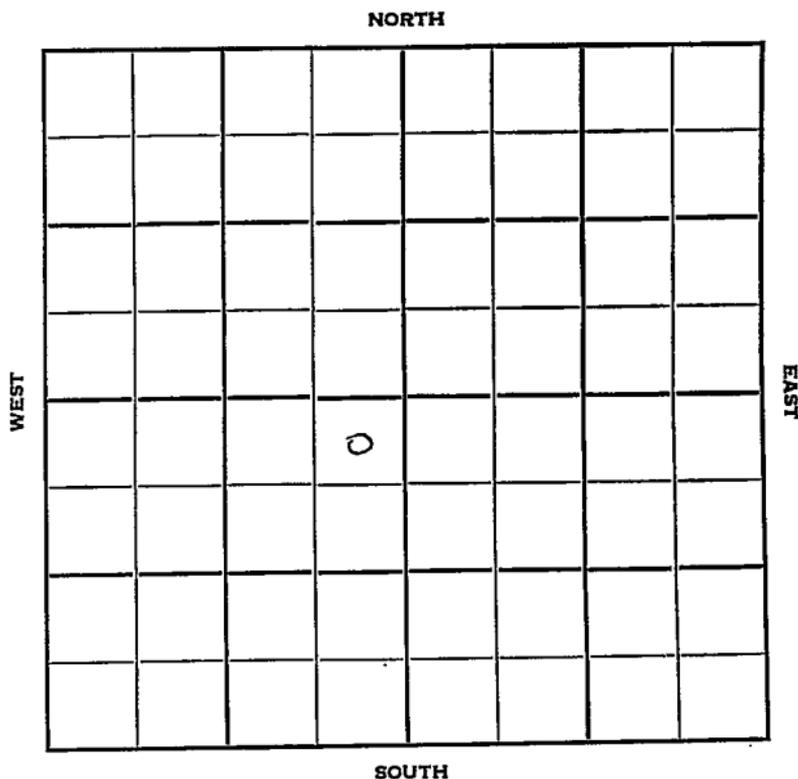

Graham

KANSAS

Sec. 15 Twp. 10 R. 22W

Well No. #1 Andreen Farm

Jones, Shelborne & Farmer Company

Contractor

Wildcat


330' Ft. from N. Line

\_\_\_\_\_ Ft. from S. Line

330' Ft. from E. Line

\_\_\_\_\_ Ft. from W. Line

NE NE SW

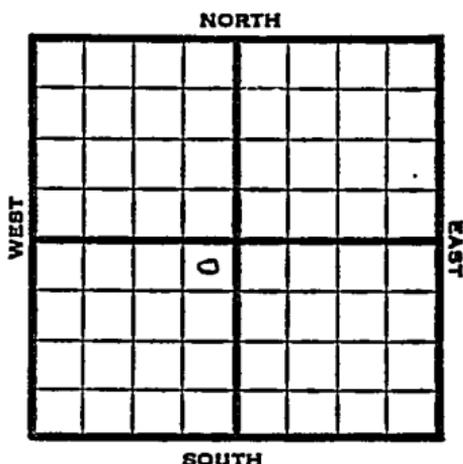

1951

Elev. 2245'

REPORT

4/4

Spud 4-2-51

8" @ 175'

WOC

4/18

Spud 4-2-51

D & A TD 3982'

8" @ 175' Anhy 1750' Heeb 3464'

Lans. 3500'

DST 3690-3703 open  $\frac{1}{2}$  hr. rec 10' mud

& SSO Cong 3817' Viola 3385-3907'

Arb. 3942-82 TD

D & A

**ABANDONED**



