


Section 15 Township 10 Range 23 W

Well No. #1 F. Law

Company Frontier Oil

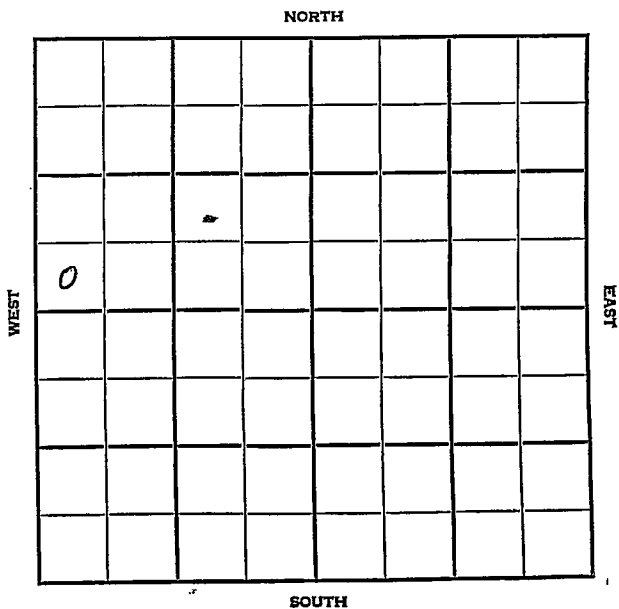

Graham

KANSAS

SEC. 15	TWP. 10	R. 23W
------------	------------	-----------

WELL NO.

#1 F. Law

FARM

COMPANY

Frontier Oil

CONTRACTOR

K &amp; K

Diebolt


\_\_\_\_\_ Ft. from N. Line

\_\_\_\_\_ Ft. from S. Line

\_\_\_\_\_ Ft. from E. Line

\_\_\_\_\_ Ft. from W. Line

SW SW NW

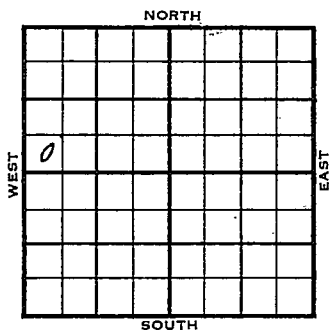

1956

ELEVATION

2395

REPORT

2-29

Location


3-21

Comm. 3-3-56  
 8 5/8" @ 250/150  
 D & A  
 Anh. 1960  
 H. 3676  
 Tr. 3695  
 L. 3710  
 BKC 3941  
 TD 3960

ABANDONED



County Graham Elev. 2395  
 Sec. 15 Twp. 10 Rge. 23W  
 Company Frontier Oil  
 Farm Name F. Law No. 1

TOPS	DEPTH	LOG	DATUM	Loc. in Sec.																								
Anh.	<u>1960</u>			SW SW NW																								
TP.																												
H.	<u>3676</u>																											
Tr.	<u>369.5</u>																											
Dg.																												
Bl.																												
L.	<u>3710</u>		<u>1315</u>	Geol.																								
K.C.				Contr.																								
B.K.C.	<u>3941</u>		<u>1546</u>																									
Ce.																												
C.																												
M.																												
M.				Pool																								
K.				<u>Diebolt</u>																								
Mz.				<table border="1"> <tr><td></td><td></td><td></td></tr> <tr><td></td><td></td><td></td></tr> <tr><td></td><td></td><td></td></tr> <tr><td></td><td></td><td></td></tr> <tr><td></td><td></td><td></td></tr> <tr><td></td><td></td><td></td></tr> <tr><td></td><td></td><td></td></tr> <tr><td></td><td></td><td></td></tr> </table>																								
V.																												
S.																												
S.																												
A																												
R.																												
PE.																												
G.																												
TD.	<u>3960</u>																											

Date Comm. 3-3-56 MAR 21 1956  
8 5/8" @ 250/150

D & A

Co.  
Lse.  
No.  
Sec.  
T.  
R.

0  
ABANDONED