

9-10-15W Inl

STATE CORPORATION COMMISSION OF KANSAS
OIL & GAS CONSERVATION DIVISION

WELL COMPLETION OR RECOMPLETION FORM
ACO-1 WELL HISTORY

DESCRIPTION OF WELL AND LEASE

Operator: license # 6588
name Woodman-Iannitti Oil Company
address P.O. Box 308
City/State/Zip Great Bend, KS 67530

Operator Contact Person K.T. Woodman
Phone (316) 265-7650

Contractor: license # 5122
name Woodman-Iannitti Drilling Co.

Wellsite Geologist John L. James
Phone (316) 262-7938

Designate Type of Completion

New Well Re-Entry Workover

Oil SWD Temp Abd
 Gas Inj Delayed Comp.
 Other (Core, Water Supply etc.)

If OWWO: old well info as follows:

Operator
Well Name
Comp. Date Old Total Depth

WELL HISTORY

Drilling Method: Mud Rotary Air Rotary Cable

8/18/84... 8/24/84... 8/24/84...
Spud Date Date Reached TD Completion Date

3610!... 3610!...
Total Depth PBDT

Amount of Surface Pipe Set and Cemented at 260 feet

Multiple Stage Cementing Collar Used? Yes No

If Yes, Show Depth Set feet

If alternate 2 completion, cement circulated
from feet depth to w/ SX cmt

API NO. 15 - 141-20,213

County Osborne

SE NE NE Sec 9 Twp 10 Rge 15 East West

4950 Ft North from Southeast Corner of Section

330 Ft West from Southeast Corner of Section

(Note: locate well in section plat below)


Lease Name Hogan Well# 7

Field Name Hobrock

Producing Formation Arbuckle

Elevation: Ground 2000 KB 2005

Section Plat

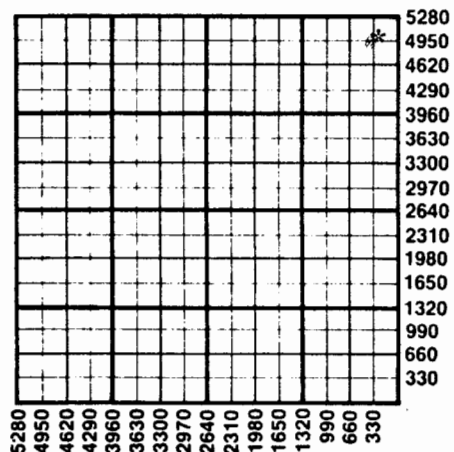

WATER SUPPLY INFORMATION

Source of Water:

Division of Water Resources Permit #

Groundwater Ft North From Southeast Corner and
(Well) Ft West From Southeast Corner of
Sec Twp Rge East West

Surface Water Ft North From Southeast Corner and
(Stream, Pond etc.) Ft West From Southeast Corner
Sec Twp Rge East West

Other (explain) (purchased from city, R.W.D.#)

Disposition of Produced Water: Disposal Repressuring

Docket #

INSTRUCTIONS: This form shall be completed in duplicate and filed with the Kansas Corporation Commission, 200 Colorado Derby Building, Wichita, Kansas 67202, within 90 days after completion or recompletion of any well. Rules 82-3-130 and 82-3-107 apply.

Information on side two of this form will be held confidential for a period of 12 months if requested in writing and submitted with the form. See rule 82-3-107 for confidentiality in excess of 12 months.

... of all wireline logs and driller's time logs shall be attached with this form. Submit CP-4 form with all plugged wells. Submit CP-111 form with

