22-10-15W

SIDE ONE

STATE CORPORATION COMMISSION OF KANSAS
OIL & GAS CONSERVATION DIVISION

WELL COMPLETION OR RECOMPLETION FORM
ACO-1 WELL HISTORY

API NO. 15 - 141-20,239

County Osborne

N/2 SW SE NE (location) Sec 22 Twp 10 Rge 15W West

3135 Ft North from Southeast Corner of Section
990 Ft West from Southeast Corner of Section
(Note: locate well in section plat below)

Lease Name KOELLING Well# 4

Field Name Ruggles

Producing Formation Arbuckle

Elevation: Ground 1821 KB 1826

DESCRIPTION OF WELL AND LEASE

Operator: license # 5364
name Beren Corporation
address 970 Fourth Financial Center
City/State/Zip Wichita, KS 67202

Operator Contact Person David Munro
Phone 316-265-3311

Contractor: license # 5147
name BEREDCO INC.

Wellsite Geologist P. Sam Houston
Phone
PURCHASER Koch

RECEIVED
STATE CORPORATION COMMISSION
DEC 21 1988
CONSERVATION DIVISION
Wichita, Kansas

Designate Type of Completion
(X) New Well ( ) Re-Entry ( ) Workover

(X) Oil ( ) SWD ( ) Temp Abd
( ) Gas ( ) Inj ( ) Delayed Comp.
( ) Dry ( ) Other (Core, Water Supply etc.)

If OWWO: old well info as follows:
Operator
Well Name
Comp. Date Old Total Depth

CONFIDENTIAL

Section Plat

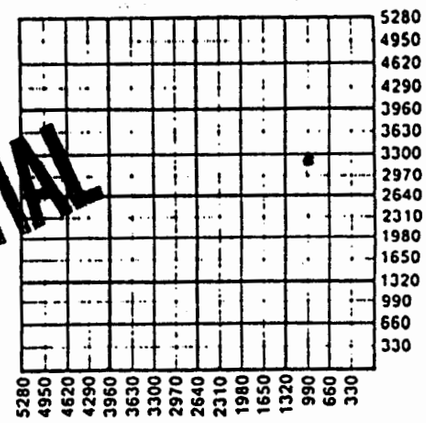

WELL HISTORY

Drilling Method: (X) Mud Rotary ( ) Air Rotary ( ) Cable

9/06/88 Spud Date
9/14/88 Date Reached TD
10-31-88 Completion Date

3408' Total Depth
3381' PBTD

Amount of Surface Pipe Set and Cemented at 630 feet

Multiple Stage Cementing Collar Used? ( ) Yes (X) No

If Yes, Show Depth Set feet

If alternate 2 completion, cement circulated
from feet depth to w/ SX cmt

WATER SUPPLY INFORMATION

Source of Water:

Division of Water Resources Permit #

( ) Groundwater Ft North From Southeast Corner and
(Well) Ft. West From Southeast Corner of
Sec Twp Rge ( ) East ( ) West

( ) Surface Water Ft North From Southeast Corner and
(Stream, Pond etc.) Ft West From Southeast Corner
Sec Twp Rge ( ) East ( ) West

( ) Other (explain)
(purchased from city, R.W.D.#)

Disposition of Produced Water: (X) Disposal ( ) Repressuring

Docket # 44631-C

Samson Oil Co.'s Ruggels "B" SWD

INSTRUCTIONS: This form shall be completed in duplicate and filed with the Kansas Corporation Commission, 200 Colorado Derby Building, Wichita, Kansas 67202, within 90 days after completion or recompletion of any well. Rules 82-3-130 and 82-3-107 apply.

Information on side two of this form will be held confidential for a period of 12 months if requested in writing and submitted with the form. See rule 82-3-107 for confidentiality in excess of 12 months.

One copy of all wireline logs and drillers time log shall be attached with this form. Submit CP-4 form with all plugged wells. Submit CP-111 form with all temporarily abandoned wells.

All requirements of the statutes, rules, and regulations promulgated to regulate the oil and gas industry have been fully complied with and the statements herein are complete and correct to the best of my knowledge.

JAN 12 1989

Signature
David Munro
Title Engineer Date 11-30-88

Subscribed and sworn to before me this 30 day of November 19 88

Notary Public
Date Commission Expires 3-20-90

SHERRY HERRELL
NOTARY PUBLIC
STATE OF KANSAS

K.C.C. OFFICE USE ONLY
F (X) Letter of Confidentiality Attached
C (X) Wireline Log Received
C ( ) Drillers Timelog Received

Distribution
( ) KCC ( ) SWD/Rep ( ) NGPA
(X) KGS ( ) Plug ( ) Other (Specify)

Sec. 22 Twp. 10 Rge. 15 E

Form ACO-1 (7-84)

KANSAS GEOLOGICAL SURVEY
WICHITA BRANCH