

DX 78-1

Rooks

KANSAS

Section 16 Township 10 S Range 18 W

Well No. # 1 Ordway "B"

Company C-G Drlg. & Hanson

NORTH

WEST

			0				

EAST

SOUTH

//

Rooks

KANSAS

SEC.	TWP.	R.
16	10 S	18 W
WELL NO.		
# 1 Ordway "B"		FARM
COMPANY		
C-G Drlg. & Hanson		
CONTRACTOR		

C-G

Williams


330' Ft. from N. Line

Ft. from S. Line

330' Ft. from E. Line

Ft. from W. Line

NE NE SW

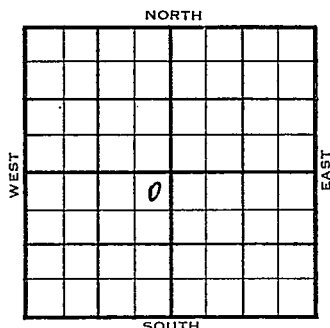

	ELEVATION	REPORT
1954	2152'	
12/8	Spud 12-2-54 8" @ 183' Anhy 1528' Drlg. 2700'	
12/15	Spud 12-2-54 D & A TD 3730' 8" @ 183' Anhy 1528', Top 3122' Heeb 3338' Tor. 3353' DST 3344'-60' opn 20 min, rec 15' Mud 135# Lans 3378' DST 3402'-20' opn 1 hr, rec 1035' s.w. 510# B KC 3591' Cong 3634' Simp 3690' Arb. 3724' DST 3725'-30' opn $\frac{1}{2}$ hr, rec 2250' Mudd S.W. 1000 # TD 3730' D & A	ABANDONED

County Rooks State KansasSec. 16 (Blk. Twp.) 10S (Sur. Rge.) 18W Map No.Operator C-G Drilg & HansonWell No. 1 Farm Ordway "B"Elev. Location NE NE SW


330 Ft. From N Line330 Ft. From E Line SW Quarter1st. Report DEC 8 1954

Completion

Remarks C-G toolsSpudding Date 12-2-54Drilg. Data Williams8" @ 183, Anh 1528, Drilg. 2700

FABEN GILSTRAP

County _____ Rocks _____ State Kansas
 Sec. 16 (Bk.) 10 (Sur.) 18W Map No. _____
 Operator C & G Drlg. & D.G. Hansen
 Well No. 1 Farm Ordway "B"
 Elev. 2152 Location NE NE SW

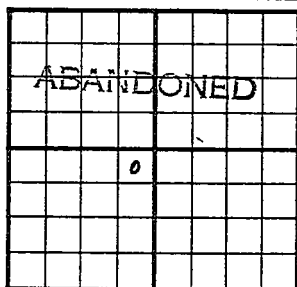

330 Ft. From N Line SW
330 Ft. From E Line Quarter
 Ist. Report _____
 Completion DEC 15 1954
 Remarks Williams Pool
C & G Drlg. - Contr.
 Spudding Date 12-2-54

Drlg. Data D & A TD 3730

8" @ 183 Anhy 1528 Top. 3122

Heeb. 3338 Tor. 3353 DST 3344-60

open 20 min. Rec. 15' mud 135#

Lans. 3378 DST 3402-20 open 1 hr.

Rec. 1035' sw 510# B KC 3591

Cong. 3634 Simp. 3690 Arb. 3724

DST 3725-30 open $\frac{1}{2}$ hr. Rec. 2250' muddy

sw 1000# TD 3730

D & A

FABEN GILSTR.