


DX 78-1

Rooks KANSAS

Section 16 Township 10 Range 18W

Well No. 3 E. C. Ordway

Company Skelly Oil

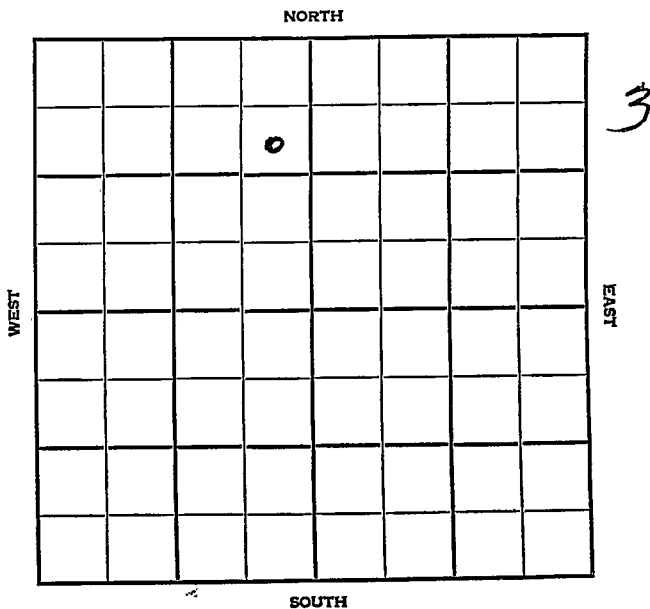

Rooks

KANSAS

SEC.	TWP.	R.
16	10	18 W

WELL NO.

3 E. C. Ordway

FARM

COMPANY

Skelly Oil

CONTRACTOR

Wentworth
Ordway Pool


990 _____ Ft. from N. Line

_____ Ft. from S. Line

330 _____ Ft. from E. Line

_____ Ft. from W. Line

SE NE NW

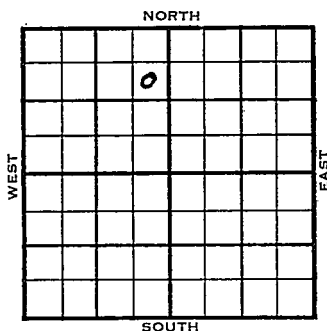

1955	ELEVATION	REPORT
	2169'	
2/2	Spud 1-28-55 8" @ 279 Drlg. 2000'	
2/16	Spud 1-28-55 D & A TD 3775' 8" @ 279' Top 3136', Heeb 3353' Tor. 3369' DST 3370'-80' opn 1 hr, rec 40' s.w. 1030# Lans 3395' DST 3410'-45' opn 45 min, rec 2845' rotary mud, 1500# DST 3443'-70' opn 1 hr, rec 530' Mud, 1000# DST 3522'-38' opn 2 hr, rec 80' mw, 1010# DST 3553'-95' opn 1/2 hr, rec 4' Mud O# Cong 3645', Simp 3723' Arb. 3742' TD 3775' D& A	ABANDONED

