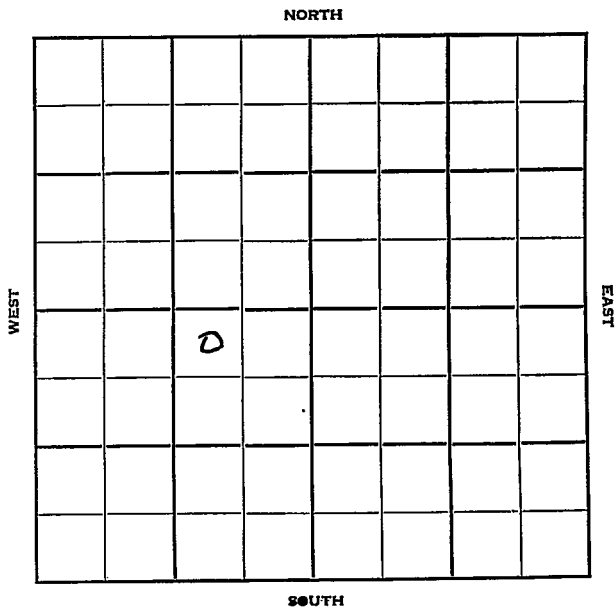


Section 16 Township 10 Range 19WWell No. #1 FehnelCompany Champlin

Sec. 16 Twp. 10 R. 19W

Well No. #1 Fehnel Farm

Champlin Company

Champlin Contractor

Wildcat


330 Ft. from N. Line

Ft. from S. Line

990 Ft. from E. Line

Ft. from W. Line

NW NE SW

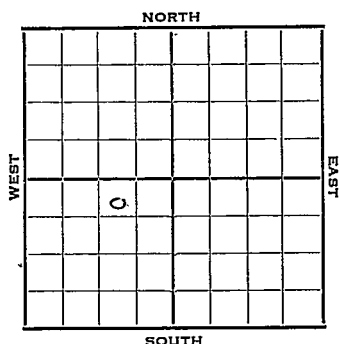

1952

2171 RB
2168 L&S

REPORT

6/25

Spud 6-18-52

8" @ 166'

Anhy 1575

Heeb. 3367

Lans. 3406

DST 3432-50, 1 hr. 240' O&GCM

& W 1000# Drlg. 3450'

7/2

DST 3452-80 1 hr. 15'M 250#

DST 3483-95 1/2 hr. 1125 clean oil
1200#

DST 3554-75 1 hr. 30' O&GCM

DST 3574-3602 1 hr. 24' M & 1' oil

540 # 15" Cong. 3658

Simp 3691 Arb. 3728

RTD 3730 Schl 5" @ 3729 WOCT

7/9

CO 3730 fill up 250 wtr PB 3650

23/3572-79 500 A 17 BF 13 hr.

7/17

S/23 BO & 9 BSW 12 hrs Set plug 3525

47/3480-94 S/14 BO 1 hr. 30% wtr

fill up 2700' oil 12 hrs. S/12 1/2 BF

30% wtr POP

7/23

NR

7/30

NR

OVER

1952

8/6

Spud 6-18-52

Oil well TD 3730' 8" @ 166

Anhy 1575' Heeb 3367' Lans. 3406'

DST 3432-50 open 1 hr. rec 240' 0 &

GCM & W 1000#

DST 3452-80 open 1 hr. rec 15' mud
250#

DST 3483-95 open $\frac{1}{2}$ hr. rec 1125' clean
oil 1200#

DST 3554-75 open 1 hr. rec 30' 0 & GCM
0#

DST 3574-3602 open 1 hr. rec 24' mud
1' oil, 540# Cong. 3658'

Re-Simp 3691' Arb. 3728'

TD 3730' 5" @ 3729 CO to 3730


FU 250' water. PB 3650 23/3572-78

500 A 17 BF 13 hr. S/23 BO 9 BAW

12 hr. SP 3525' 47/3480-94

S/14 BO 1 hr. 30% water.

COMPLETED

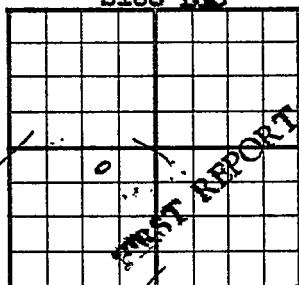County Rooks State KansasSec. 16 (Blk.) 10 (Sur.) 19W Map No.Operator ChamplinWell No. 1 Farm FehnelElev. 2171 RB Location NW NE SW
2168 L&S330 Ft. From N Line SW990 Ft. From E Line Quarter1st. Report JUN 25 1952

Completion

Remarks

Champlin - Contr.Spudding Date 6-18-52Drlg. Data Wildcat8" @ 166 Anhy 1575 Heeb 3367 Lens 3406DST 3432-50 1hr. 240' O&GCM & W 1000#Drlg. 3450J. G. McGEHEE


County _____ Rocks _____ State Kansas

Sec. 16 (Blk.) 10 (Sur. Rge.) 19W Map No. _____

Operator Champlin Ref.

Well No. 1 Farm Fehnel

Elev. 2171 RB 2168 LS Location NW NE SW

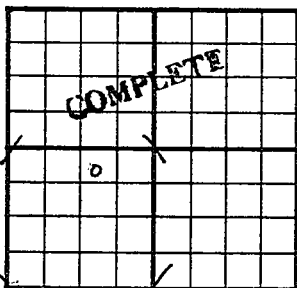

330 Ft. From N Line SW

990 Ft. From E Line Quarter

1st. Report

Completion AUG 6 1952

Remarks Wildcat

Champlin - Contr.

Spudding Date 6-18-52

Drilg. Data Oil well TD 3730

8" @ 166 Anhy 1575 Heeb. 3367

Lans. 3406 DST 3432-50 open 1 hr.

Rec. 240' o & gcm & w 1000# DST 3452-80

open 1 hr. Rec. 15' mud 250# DST 3483-

95 open 1/2 hr. Rec. 1125' clean oil

1200# DST 3554-75 open 1 hr.

Rec. 30' o & gcm 0# DST 3574-3602

open 1 hr. Rec. 24' mud 1' oil 540#

Confg. 3658 ReSimp. 3691 Arb. 3728

TD 3730 5" @ 3729 CO to 3730 FU 250'

water PB 3650 23/ 3572-78 500 A.

17 bf 13 hr. S/ 23 bo 9 baw 12 hr.

SP 3525 47/ 3480-94 S/ 14 bo 1 hr.

30% water

J. G. McGEHEE

Drlg. Data

FU 2700' oil 12 hr. S/ $12\frac{1}{2}$ bf 30% wtr.

P/ 300 bf 24 hr. 30% wtr.

Comp. 245 bond 23% wtr on

AUG 11 1952

Scout Cards	
Land Small Map	
Land Wall Map	
Irregulars	
France Map	
Pt. Map	
Misc.	