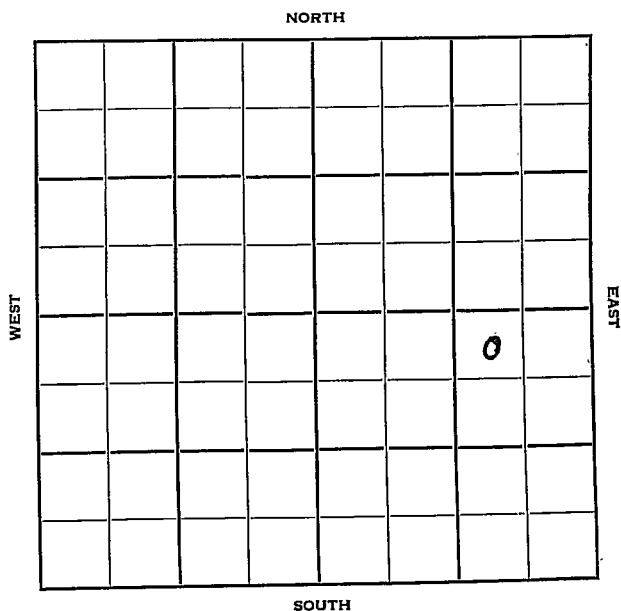


Section 16 Township 10 Range 20 WWell No. # 1 ShawCompany C & G Drlg.

Rooks


KANSAS

Sec. 16 Twp. 10 R. 20WWell No. #1 Shaw FarmC & G Drlg. CompanyC & G Drlg. Contractor

Marcotte Pool

330 Ft. from N. Line Ft. from S. Line990 Ft. from E. Line Ft. from W. Line

NW NE SE

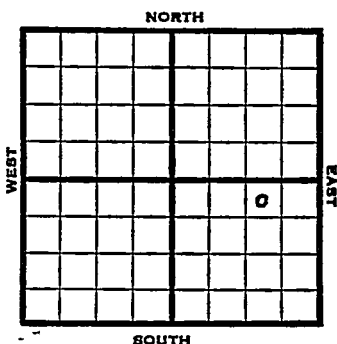

1953 Elev. 2209' REPORT

4/15 Cellar & Pits

4/23 8" @ 169'
Anhy 1693
Drlg. 3080'

4/29 Spud 4-15-53

D&A

TD 3825


8" @ 169'

Anhy 1693, Heeb 3448, Tor 3471, Lans
3487, B KC 3707, Cong 3750, Arb 3797

TD 3825

D&A

ABANDONED

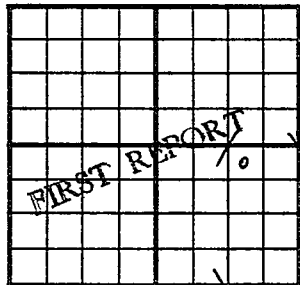
County Rooks State KansasSec. 16 (Blk.
Twp.) 10 (Sur.
Rge.) 20W Map No.Operator C & G Drlg.Well No. 1 Farm ShawElev. Location NW NE SE330 Ft. From N Line SE990 Ft. From E Line Quarter1st. Report APR 15 1953CompletionRemarksC & G Drlg. - Contr.Spudding DateDrlg. Data Marcotte PoolCellar & pits

County _____ Rooks _____ State Kansas
 Sec. 16 (Blk.) 10 (Sur.) 20W Map No. _____
 (Twp.) (Rge.)

Operator C & G Drlg.

Well No. 1 Farm Shaw

Elev. 2209 Location NW NE SE

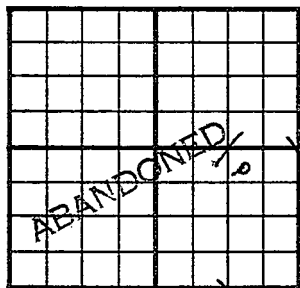

330 Ft. From N Line SE

990 Ft. From E Line Quarter

1st. Report

Completion APR 29 1953

Remarks Marcotte Pool

C & G Drlg. - Contr.

Spudding Date 4-15-53

Drlg. Data D & A TD 3825

8" @ 169 Anhy 1693 Heeb. 3448

Tor. 3471 Lans. 3487 B KC 3707

Cong. 3750 Arb. 3797 TD 3825

D & A

J. G. McGEHEE