


Rooks

KANSAS

Section 16 Township 10 Range 20W

Well No. #1 Williams

Company Heathman Drlg.

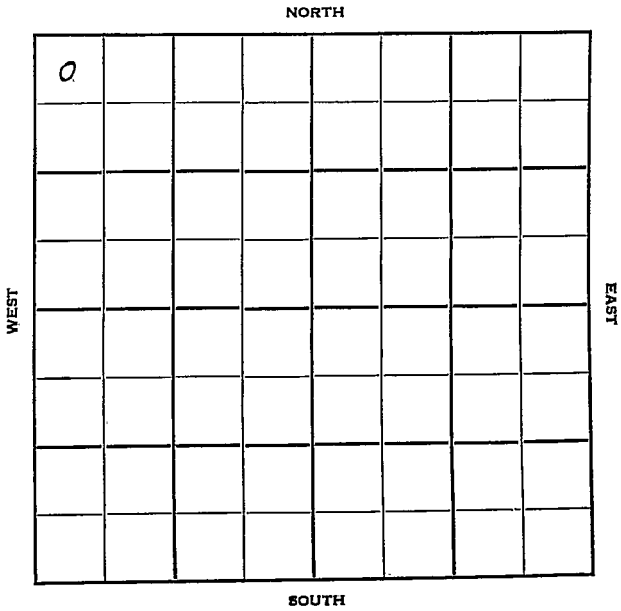

Rooks

KANSAS

Sec. 16 Twp. 10 R. 20W

Well No. #1 Williams Farm

Heathman Drlg. Company

Contractor

Wildcat


330' Ft. from N. Line

Ft. from S. Line

Ft. from E. Line

330' Ft. from W. Line

NW NW NW

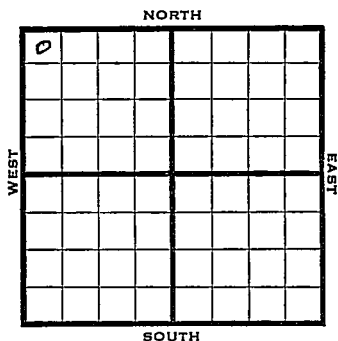

1950

Elev 2244' REPORT

3/29

Spud 3-25-50

8" @ 130'

Drlg. 1328'

4/26

TD 3821'

8" @ 130

Anhy 1732-65

Topeka 3280'

Heebner 3485'

KC 3528'

DST 3558-78

Rec salt wtr.

BKC 3750'

Cong 3786'

Simp 3798'

Arb. 3813'

5" @ 3841'

DD 3821'

FU 400' oil ph

500 acid

Swab 15 BOPH

Comp 352 BOPD no wtr.

Comp

COMPLETED

Map No. _____ Sec. 16 Twp. 10 R. 2 OWWell No. 1 Williams

Heathman Drlg.

Company

Contractor


NW NW NW

SECTION PLAT

330 Ft. from N. Line

_____ Ft. from S. Line

_____ Ft. from E. Line

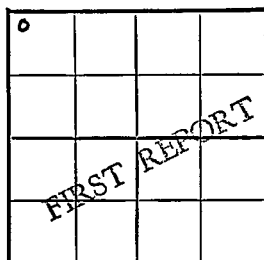330 Ft. from W. Line

Rooks County

Magnolia farmout

Location _____

Rig up _____

Drilling and Remarks:

Spud 3-25-50

8" @ 130

drlg. 1328

RECORD

Cased _____ in., _____ ft.

Sand _____

Gas _____

Oil _____

Total Depth _____

PRODUCTION

1st 24 hrs. Nat. _____

1st 24 hrs. after shot _____

Gas _____ Cu. Ft.

Dry Hole _____

Abandoned _____

Date

MAR 29 1950

19

J. E. TYRA

Scout

Map No. _____ Sec. 16 Twp. 10 R. 20WWell No. 1 Williams


_____ Heathman Drlg. _____ Company

_____ Contractor

NW NW NW

E. 2244

SECTION PLAT

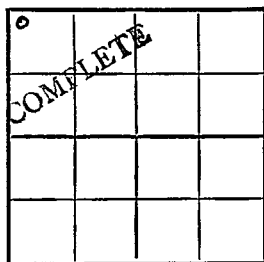330 Ft. from N. Line

_____ Ft. from S. Line

_____ Ft. from E. Line

330 Ft. from W. Line

Rooks County

Location _____

Rig up _____

Drilling and Remarks:

8" C 130
 anky 1732-65
 20 pkr 3280
 Wellner 3485
 K.C. 3528
 DST 3558-78
 Rec. salt water
 B K.C. 3750

RECORD

Cased _____ in., _____ ft.

Sand _____

Gas _____

Oil _____

Total Depth 3821

PRODUCTION

1st 24 hrs. Nat. _____

1st 24 hrs. after shot _____

Gas _____ Cu. Ft.

Dry Hole _____

Abandoned _____

Date

APR 26 1950 19 J. E. TYRA Scout

Cong. 3786
 Simp. 3798
 Arb. 3813
 5" C 3814
 DD 3825
 7U 400' ails
 500 acid
 Swab 15 bph
 Comp. 352 bph - no water

.....	Misc.
.....	Pierce Map
.....	France Map
.....	Tracings
.....	Land Wall Map
.....	Land Small Map
.....	Scout Cards

REC. 112

REC. 112

REC. 112